

COPY

RECEIVED FOR RECORD
LIBER NO. _____ PAGE NO. _____
1997 REMONUMENTATION PROGRAM
LAND CORNER RECORDATION CERTIFICATE NO. #37
ELMWOOD TOWNSHIP
Filing Requirement of Act 74, Mich. P.A. 1970
97 OCT -9 PM 1:07

For corners in: ELMWOOD TWP.

<u>TUSCOLA</u> (County)	Located In:	Corner Code #
1. Public Land Survey	T <u>14N</u> R <u>10E</u>	<u>D-13</u>
	T _____ R _____	_____
	T _____ R _____	_____
	T _____ R _____	_____
2. Property Controlling in Section	S _____ T _____ R _____	_____
	S _____ T _____ R _____	_____
3. Miscellaneous Property in Sec.	S _____ T _____ R _____	_____
	S _____ T _____ R _____	_____
4. Lot No. _____, Recorded Plat _____		
5. Private Claims _____		

Jimmy Johnson
TUSCOLA COUNTY
REGISTER OF DEEDS

Register of Deeds Stamp & File Number

	A	B	C	D	E	F	G	H	I	J	K	L	M
1													
2	6	5	4	3	2	1							
3													
4	7	8	9	10	11	12							
5													
6	18	17	16	15	14	13							
7													
8	19	20	21	22	23	24							
9													
10	30	29	28	27	26	25							
11													
12	31	32	33	34	35	36							
13													

I, JONATHAN M. FIELD, in a field survey on JULY 25 1997, do hereby certify that under requirements of P.A. 74, Michigan P.A. of 1970, the corner points mentioned in lines 1 and 2 above were in conformance with regulations and rules therefore as required in the current manual of survey instructions of the United States Department of the Interior, Bureau of Land Management or by a decree of a Court of Law and/or that the corner points mentioned in lines 3, 4 and 5 above were in conformance with the rules of the Michigan Board of Land Surveyors or by a Decree of a Court of Law; established, re-established, monumented, re-monumented, recovered, found as expressed below:

NOTE: Not more than 4 corners, all in the same town and range, may be recorded on this certificate.


A. Description of original monument and accessories and/or subsequent restoration:
1835 GLO; PARKE, D.S.; SET 1/4 SEC. POST; SUGAR 9 N55E 41LKS., SUGAR 9 N70 1/2W 11LKS.
1976 ROWE; BECK, P.S.#21559; SURVEY L.459 PG.620-621; 1/2" ROD; NORTH 33.00' 1/2" ROD, S40W 44.58' P-K NAIL IN 7" CHERRY, WEST 10' ± OCC. N-S 1/4 LINE SEC. 5
1976 BECK, P.S.#21559; LCRC PG. 19; SET 1/2" ROD; SAME WITS AS 1976 SURVEY CITED ABOVE
1987 DUNTON LAND SURVEYING; DUNTON, P.S.#23503; SURVEY L.578 PG.30; FND 1/2" ROD; SAME WITS AS 1976 SURVEY CITED ABOVE
1991 DUNTON LAND SURVEYING; DUNTON, P.S.#23503; UNRECORDED SURVEY JOB. NO.1272-91; 1/2" ROD; WITS FOR C-1 T13N-R10E SHOW EAST 10.23 TO C-13 T14N-R10E

B. Description of corner evidence found and/or method applied in restoring or reestablishing corner:
1997 ROWE; FIELD, P.S.#37276; FND. 1/2" ROD; RECOVERED 1 PREVIOUS WITNESS WHICH INDICATES THAT FND. ROD IS IN SAME POSITION AS 1976 SURVEY CITED IN SECTION A. ABOVE

ACCEPTED FND. ROD AS BEST AVAILABLE EVIDENCE OF THE ORIGINAL CORNER POSITION

C. Description of monument for corner and accessories established to perpetuate locating the position of the corner:
D-13 REPLACED FND. ROD W/ STD. REMON. MONUMENT STAMPED D 13 T14N R10E IN MON. BOX WEST, 10.20' FND. 1/2" ROD W/ BROKEN CAP APPARENT CORNER D-1 T13N-R10E
S62°W, 32.03' SET 1/2" ROD W/CAP #37276
N66°W, 32.74' SET 1/2" ROD W/CAP #37276
N64°E, 32.55' SET 1/2" ROD W/CAP #37276
S63°E, 32.44' SET 1/2" ROD W/CAP #37276
NORTH, 32.77' FND. 3/4" PIPE

Signed by Jonathan M. Field, Date 10-7-97
Surveyor's Michigan License No. 37276

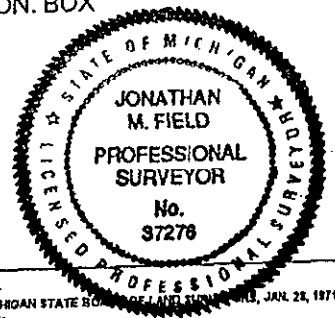

FORM APPROVED BY MICHIGAN STATE BOARD OF LAND SURVEYORS, JAN. 28, 1974
REVISED MAY 14, 1975
REVISED JAN. 1983
ADAPTED FOR WORD PROCESSING MARCH, 1983

APPROVED
10-6-97

Handwritten initials: HOD, JLF, RAB

SURVEY &
REMONUMENTATION

NOV 26 1997

COMMISSION

