

## 1997 REMONUMENTATION PROGRAM LAND CORNER RECORDATION CERTIFICATE

Filing Requirement of Act 74, Mich. P.A. 1970

RECEIVED FOR RECORD THE NO. #38 1. MWOOD TOWNSHIP 97 OCT -9 PM 1:07

any more

Register of Deeds Stamp & File Number

ELMWOOD TWP. For corners in: Corner Code # Located In: TUSCOLA T14N R 10E 1. Public Land Survey 2. Property Controlling in Section Miscellaneous Property in Sec. , Recorded Plat 4. Lot No. Private Claims

I, JONATHAN M. FIELD , in a field survey on JULY 25 19 97 , do hereby certify that under requirements of P.A. 74, Michigan P.A. of 1970, the corner points mentioned in lines 1 and 2 above were in conformance with regulations and rules therefore as required in the current manual of survey instructions of the United States Department of the Interior. Bureau of Land Management or by a decree of a Court of Law and/or that the corner points mentioned in lines 3, 4 and 5 above were in conformance with the rules of the Michigan Board of Land Surveyors or by a Decree of a above were in conformance with the rules of the Michigan Board of Land Surveyors or by a Decree of a Court of Law; established, re-established, monumented, re-monumented, recovered, found as expressed below:

NOTE: Not more than 4 corners, all in the same town and range, may be recorded on this certificate.

| , A B C   | . D E  | FG  | H 1 | JK | L M              |
|-----------|--------|-----|-----|----|------------------|
| 2 6       | 5      | 4   | 3   | 2  | <mark> </mark> . |
| 3 - 7 - 1 | . 8    | 9   | 10  | 1  | 12               |
| 6 18      | <br>לו | -16 | 15  | 14 | 13               |
| 8 19      | 20     | 21  | 22  | 23 | . 24             |
| 10 30     | 29     | 28  | 27  | 26 | 25               |
| 12 31     | 32     | 33  | 34  | 35 | 36               |

Description of original monument and accessories and/or subsequent restoration: 1835 GLO; PARKE, D.S.; SET POST; BEECH 12 N58E 28LKS., HEMLOCK 12 N50W 25 1/2LKS.

Description of corner evidence found and/or method applied in restoring or reestablishing corner: Description of control evidence found allow thermos applied in restoring of reestablishing pointer.

1997 ROWE; FIELD, P.S.#37276; FND. NO EVIDENCE OF MONUMENT AT CORNER POSITION; RE-ESTABLISHED CORNER POSITION BY SINGLE PROPORTION BETWEEN D-13 & F-13 T14N-R10E

ACCEPTED SINGLE PROPORTION AS BEST RE-ESTABLISHMENT OF THE ORIGINAL CORNER POSITION

Description of monument for corner and accessories established to perpetuate locating the position of the corner

SET STD. REMON. MONUMENT STAMPED E 13 T14N R10E IN MON. BOX

WEST. 26.72' FND. 1/2" ROD W/CAP #23503 APPARENT E-1 T13N-R10E

N35°W, 39.66' FND. P-K W/FLAG. IN S. FACE 4X6 POST

N74°E, 83.09' SET CHIS. NOTCH IN N. END 15" CMP

878°E, 80.79' SET CHIS. NOTCH IN S. END 15" CMP

S66°E, 61.06' SET NAIL W/TAG #37276 IN CENTER OF 24" STUMP

SOUTH, 28.42' SET 1/2" ROD W/CAP #37276

S58°W, 58.70' CENTER OF ROAD SIGN POST

Signed by 37276

Surveyors Michigan License No.

JONATHAN

M. FIELD

PROFESSIONAL

ROYSVAUS


37278

BOFESS

SUMVEY & REMONUMENTATIO APPROVED

NOV 2 6 1997

COMMISSION

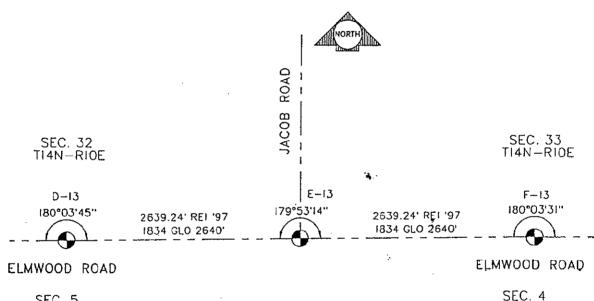

SEC. 5 TI3N-RI0E

SEC. 4 TI3N-RIOE