

COPY

RECEIVED FOR RECORD

1997 REMONUMENTATION PROGRAM
LAND CORNER RECORDATION CERTIFICATE

LIBER NO. _____ PAGE NO. _____

FILE NO. #39
ELMWOOD TOWNSHIP

Filing Requirement of Act 74, Mich. P.A. 1970

97 OCT -9 PM 1:07

For corners in: ELMWOOD TWP.

<u>TUSCOLA</u> (County)	Located In:	Corner Code #
1. Public Land Survey	T <u>14N</u> R <u>10E</u>	<u>F-13</u>
	T _____ R _____	_____
	T _____ R _____	_____
	T _____ R _____	_____
2. Property Controlling in Section	S _____ T _____ R _____	_____
	S _____ T _____ R _____	_____
3. Miscellaneous Property in Sec.	S _____ T _____ R _____	_____
	S _____ T _____ R _____	_____

Jonathan M. Field
TUSCOLA COUNTY
REGISTER OF DEEDS

Register of Deeds Stamp & File Number

4. Lot No. _____, Recorded Plat _____
5. Private Claims _____

	A	B	C	D	E	F	G	H	I	J	K	L	M
1													
2	6	5	4	3	2	1							
3													
4	7	8	9	10	11	12							
5													
6	18	17	16	15	14	13							
7													
8	19	20	21	22	23	24							
9													
10	30	29	28	27	26	25							
11													
12	31	32	33	34	35	36							
13													

I, JONATHAN M. FIELD, in a field survey on JULY 25 19 97, do hereby certify that under requirements of P.A. 74, Michigan P.A. of 1970, the corner points mentioned in lines 1 and 2 above were in conformance with regulations and rules therefore as required in the current manual of survey instructions of the United States Department of the Interior, Bureau of Land Management or by a decree of a Court of Law and/or that the corner points mentioned in lines 3, 4 and 5 above were in conformance with the rules of the Michigan Board of Land Surveyors or by a Decree of a Court of Law; established, re-established, monumented, re-monumented, recovered, found as expressed below:


NOTE: Not more than 4 corners, all in the same town and range, may be recorded on this certificate.

A. Description of original monument and accessories and/or subsequent restoration:
1835 GLO; PARKE, D.S.; SET 1/4 SEC. POST; BEECH 9 N56 1/2E 38LKS., HEMLOCK 10 N59W 49LKS.
1972 ROWE; ROWE, P.S.#11192; SURVEY L.1 PG.522-523; SET "T" AS OCCUPIED; NORTH 33.00' T-IRON, WEST 27.06' N 1/4 COR. SEC. 4 T13N-R10E, S35W 43.10' NAIL & CAP IN ANCHOR POST
1973 ROWE, P.S.#11192; LCRC PG.10; SET "T" IRON AS OCCUPIED USING C/L OF RD AND FENCE LINES; SAME WITS AS 1972 SURVEY CITED ABOVE

B. Description of corner evidence found and/or method applied in restoring or reestablishing corner:
1997 ROWE; FIELD, P.S.#37276; FND. T-IRON; RECOVERED 1 PREVIOUS WITNESS WHICH INDICATES THAT FND. T-IRON IS IN SAME POSITION AS 1972 SURVEY CITED IN SECTION A ABOVE; ALSO FND. FRAGMENTS OF WOOD BELOW FND. T-IRON

ACCEPTED FND. T-IRON AS BEST AVAILABLE EVIDENCE OF THE ORIGINAL CORNER POSITION

C. Description of monument for corner and accessories established to perpetuate locating the position of the corner:
F-13 REPLACED FND. T-IRON W/ STD. REMON. MONUMENT STAMPED F 13 T14N R10E IN MON. BOX
WEST, 27.12' FND. R.R. SPIKE APPARENT CORNER F-1 T13N-R10E
N60°E, 91.72' SET P-K NAIL W/TAG #37276 IN NW FACE P.POLE
S62°E, 101.48' SET P-K NAIL W/TAG #37276 IN N. FACE P.POLE
S48°E, 43.90' SET NAIL W/TAG #37276 IN SW FACE 12" ELM
S73°W, 49.49' SET 1/2" ROD W/CAP #37276
N73°W, 49.21' SET 1/2" ROD W/CAP #37276

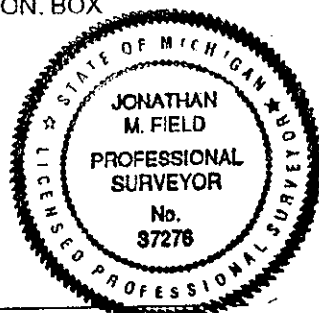

Signed by *Jonathan M. Field* Date 9-30-97
Surveyor's Michigan License No. 37276

FORM APPROVED BY MICHIGAN STATE BOARD OF LAND SURVEYORS, JAN. 28, 1971
REVISED MAY 14, 1975
REVISED JAN., 1983
ADAPTED FOR WORD PROCESSING MARCH, 1993

APPROVED
9-29-97
[Signature]
R.O.B.

SURVEY &
REMONUMENTATION

NOV 26 1997

COMMISSION

