

COPY

1997 REMONUMENTATION PROGRAM
LAND CORNER RECORDATION CERTIFICATE
Filing Requirement of Act 74, Mich. P.A. 1970

RECEIVED FOR RECORD
LICER NO. _____ PAGE NO. _____
FILE NO. #41
ELMWOOD TOWNSHIP
97 OCT -9 PM 1:07

For corners in: ELMWOOD TWP.

<u>TUSCOLA</u> (County)	Located In:	Corner Code #
1. Public Land Survey	T <u>14N</u> R <u>10E</u>	<u>H-13</u>
	T _____ R _____	_____
	T _____ R _____	_____
	T _____ R _____	_____
2. Property Controlling in Section	S _____ T _____ R _____	_____
	S _____ T _____ R _____	_____
3. Miscellaneous Property in Sec.	S _____ T _____ R _____	_____
	S _____ T _____ R _____	_____

Jonathan M. Field
TUSCOLA COUNTY
REGISTER OF DEEDS

Register of Deeds Stamp & File Number

4. Lot No. _____ Recorded Plat _____
5. Private Claims _____

1	A	B	C	D	E	F	G	H	I	J	K	L	M
2	6	5	4	3	2	1							
3													
4	7	8	9	10	11	12							
5													
6	18	17	16	15	14	13							
7													
8	19	20	21	22	23	24							
9													
10	30	29	28	27	26	25							
11													
12	31	32	33	34	35	36							
13													

I, JONATHAN M. FIELD, in a field survey on JULY 25 19 97, do hereby certify that under requirements of P.A. 74, Michigan P.A. of 1970, the corner points mentioned in lines 1 and 2 above were in conformance with regulations and rules therefore as required in the current manual of survey instructions of the United States Department of the Interior, Bureau of Land Management or by a decree of a Court of Law and/or that the corner points mentioned in lines 3, 4 and 5 above were in conformance with the rules of the Michigan Board of Land Surveyors or by a Decree of a Court of Law; established, re-established, monumented, re-monumented, recovered, found as expressed below:

NOTE: Not more than 4 corners, all in the same town and range, may be recorded on this certificate.

A. Description of original monument and accessories and/or subsequent restoration:
1835 GLO; PARKE, D.S.; SET 1/4 SEC. POST; LYNN 11 N23 1/2E 8LKS., BEECH 6 N75W 37LKS.
1891 FELTON, C.S.; SURVEY OF SEC. 34; SET STONE & BRICK FROM MEAS.; ELM 14 S41E 59LKS.
1957 BLACK, P.S.#3314; UNRECORDED SURVEY FOR MILDRED WARRINGTON ESTATE; CORNER SHOWN; NO OBJECT STATED; NO WITS GIVEN
1973 ROWE, P.S. #11192; LCRC PG.10; FND. P-K NAIL; SOUTH 28.71' TAG IN P.POLE, NORTH 27.69' NAIL IN A. POST, NORTH 0.5'± C/L ROAD
1976 TOMMER; LCRC PG.14; FND. CROCKERY, GLASS & CAST IRON, SET T-IRON; WEST 21.60' 3/4" IRON, NORTH 85.55' SE COR. OF BLDG., S70W (NO DIST.) TOP PHONE RISER
1979 CASE SURVEYING; CASE, P.S. #15399; SURVEY L.500 PG.913; FND. T-IRON; S15W 20.05' NAIL IN 12" ASH, S70W 94.52' NAIL IN P.POLE, N70W 82.65' GAS MARKER POST


B. Description of corner evidence found and/or method applied in restoring or reestablishing corner:
1997 ROWE; FIELD, P.S.#37276; FND. T-IRON; RECOVERED 1 PREVIOUS WITNESS WHICH INDICATES THAT FND. T-IRON IS IN SAME POSITION AS 1976 SURVEY CITED IN SECTION A ABOVE; ALSO FND. CROCKERY, BRICK AND LARGE STONE BELOW FND. T-IRON

ACCEPTED FND. T-IRON AS BEST AVAILABLE EVIDENCE OF THE ORIGINAL CORNER POSITION

C. Description of monument for corner and accessories established to perpetuate locating the position of the corner:
H-13 REPLACED FND. T-IRON W/ STD. REMON. MONUMENT STAMPED H 13 T14N R10E IN MON. BOX
WEST, 21.35' FND. 3/4" PIPE APPARENT CORNER H-1 T13N-R10E
N57°W, 58.20' SET P-K NAIL W/TAG #37276 IN SW FACE T.POLE
S24°W, 20.03' SET NAIL W/TAG #37276 IN NW FACE 14" ASH
S70°W, 94.08' FND. P-K NAIL IN N. FACE P.POLE
N21°E, 32.95' SET NAIL W/TAG #37276 IN NW FACE 5" ELM

Signed by *Jonathan M. Field*
Surveyor's Michigan License No. 37276

Date 9-30-97

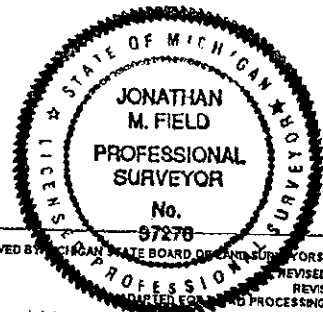

FORM APPROVED BY MICHIGAN STATE BOARD OF LAND SURVEYORS, JAN. 28, 1974
REVISED MAY 14, 1978
REVISED JAN., 1993
ADAPTED FOR E-FILE PROCESSING MARCH, 1993

APPROVED
9-29-97

*1500
JMC
9/29/97*

SURVEY &
REMONUMENTATION

NOV 26 1997

COMMISSION

