

1997 REMONUMENTATION PROGRAM LAND CORNER RECORDATION CERTIFICATE

Filing Requirement of Act 74, Mich. P.A. 1970

RECEIVED FOR RECORD
LIBER HO. FAGE HO.
FILE 1:0 #43 %
ELMWOOD TOWNSHIF
9/1001-9 PN 1:07

ELMWOOD TWP. For corners in: TUSCOLA Located In: Corner Code # (County) 1. Public Land Survey T14N R10E J-13 2. Property Controlling in Section Register of Deeds Stamp & File Number 3. Miscellaneous Property in Sec. DEF G н 4. Lot No. Recorded Plat 2 5. Private Claims Ż 6 5 Δ 7 3 4 ģ 8 10 11 12 5 I, JONATHAN M. FIELD JULY 25 , in a field survey on 19 97 do hereby certify that under requirements of P.A. 74, Michigan P.A. of 1970, the corner points mentioned 6 18 -17 16 15 14 13 in lines 1 and 2 above were in conformance with regulations and rules therefore as required in the 7 current manual of survey instructions of the United States Department of the Interior, Bureau of Land Management or by a decree of a Court of Law and/or that the corner points mentioned in lines 3, 4 and 5 above were in conformance with the rules of the Michigan Board of Land Surveyors or by a Decree of a ...10 วก 8 21 22 23 24 Q Court of Law; established, re-established, monumented, re-monumented, recovered, found as expressed below: 10 30 20 28 27 26 25 11 NOTE: Not more than 4 corners, all in the same town and range, may be recorded 12 32 31 35 34 36 on this certificate. 13 Description of original monument and accessories and/or subsequent restoration: 1835 GLO; PARKE, D.S.; SET 1/4 SEC. POST; SUGAR 15 N54W 12LKS., BEECH 6 N42E 26LKS. 1979 QUIST; LCRC PG.23; FND. LARGE STONE ON LINE W/ FENCE TO N., SET CHIS. + & PIECES OF IRON AROUND; NORTH 33' STUB OF STEEL POST IN CONC., NORTH 26.40' TAG #11192 IN 8" MAPLE, N35E 52.00' TAG #11192 IN 8" ASH, N45E 152.40' SW COR, HOUSE FOUNDATION Description of corner evidence found and/or method applied in restoring or reestablishing corner: 1997 ROWE; FIELD, P.S.#37276; FND. LARGE STONE W/ CHIS. +; RECOVERED 2 PREVIOUS WITNESSES WHICH INDICATE THAT FND. STONE IS IN SAME POSITION AS 1979 LCRC CITED IN SECTION A ABOVE ACCEPTED FND. STONE AS BEST AVAILABLE EVIDENCE OF THE ORIGINAL CORNER POSITION Description of monument for corner and accessories established to perpetuate locating the position of the corner: REPLACED FND. STONE W/ STD. REMON. MONUMENT STAMPED J 13 T14N R10E N65°W, 35.99' SET 1/2" ROD W/CAP #37276 OF MICH N28°E, 51.61' SET NAIL W/TAG #37276 IN W. FACE 12" APPLE S80°E, 124.17' SET P-K NAIL W/TAG #37276 IN SW FACE T.POLE JONATHAN S70°W, 35.01' SET 1/2" ROD W/CAP #37276 M. FIELD S68°W, 132.46' SET P-K NAIL W/TAG #37276 IN SE FACE P.POLE PROFESSIONAL N45E, 152.4' SW CORNER OF HOUSE BURVEYOR

Surveyor's Michigan License No. _

Signed by

ate 9-30-97

APPROVED

N STATE BOARD OF LAND SURVEYORS, JAN. 28, 1971

\$7278

POFESS


REVISED MAY 14, 1975 REVISED JAN., 1983 ADAPTED FOR WORD PROCESSING MARCH, 1983

BEMONUMENTATION

37276

NOV 2 6 1997

ODM/www.com-

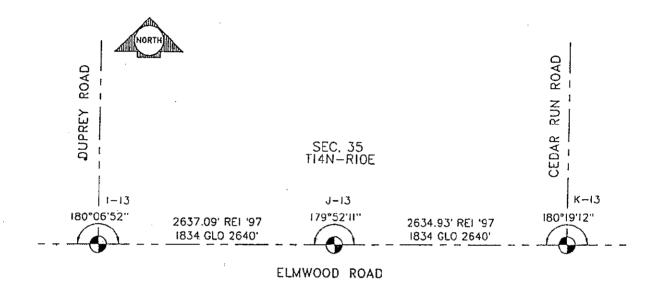

SEC. 2 TI3N-RIOE