

COPY

1997 REMONUMENTATION PROGRAM  
LAND CORNER RECORDATION CERTIFICATE  
Filing Requirement of Act 74, Mich. P.A. 1970

RECEIVED FOR RECORD  
LIBER NO. \_\_\_\_\_ PAGE NO. \_\_\_\_\_  
FILE NO. #45  
ELMWOOD TOWNSHIP  
97 OCT -9 PM 1:07

For corners in: ELMWOOD TWP.

<u>TUSCOLA</u> (County)	Located In:	Corner Code #
1. Public Land Survey	T <u>14N</u> R <u>10E</u>	<u>L-13</u>
	T _____ R _____	_____
	T _____ R _____	_____
	T _____ R _____	_____
2. Property Controlling in Section	S _____ T _____ R _____	_____
	S _____ T _____ R _____	_____
3. Miscellaneous Property in Sec.	S _____ T _____ R _____	_____
	S _____ T _____ R _____	_____

*Gregory M. ...*  
TUSCOLA COUNTY  
REGISTER OF DEEDS

Register of Deeds Stamp & File Number

4. Lot No. \_\_\_\_\_, Recorded Plat \_\_\_\_\_  
5. Private Claims \_\_\_\_\_

1	A	B	C	D	E	F	G	H	I	J	K	L	M
2	6	5	4	3	2	1							
3													
4	7	8	9	10	11	12							
5													
6	18	17	16	15	14	13							
7													
8	19	20	21	22	23	24							
9													
10	30	29	28	27	26	25							
11													
12	31	32	33	34	35	36							
13													

I, JONATHAN M. FIELD, in a field survey on JULY 25 19 97, do hereby certify that under requirements of P.A. 74, Michigan P.A. of 1970, the corner points mentioned in lines 1 and 2 above were in conformance with regulations and rules therefore as required in the current manual of survey instructions of the United States Department of the Interior, Bureau of Land Management or by a decree of a Court of Law and/or that the corner points mentioned in lines 3, 4 and 5 above were in conformance with the rules of the Michigan Board of Land Surveyors or by a Decree of a Court of Law; established, re-established, monumented, re-monumented, recovered, found as expressed below:


NOTE: Not more than 4 corners, all in the same town and range, may be recorded on this certificate.

A. Description of original monument and accessories and/or subsequent restoration:  
1835 GLO; PARKE, D.S.; SET 1/4 SEC. POST; BEECH 24 N43W 10 1/2LKS., BEECH 9 N66E 31LKS.  
1987 HURON SURVEYING; BROWN, P.S.#24588; SURVEY L.572 PG.330; FND. T-BAR; N30E 28.88' NAIL IN 36" MAPLE, NORTH 25.44' NAIL IN 30" MAPLE, SOUTH 33.25' T-BAR

B. Description of corner evidence found and/or method applied in restoring or reestablishing corner:  
1997 ROWE; FIELD, P.S.#37276; FND. T-IRON; RECOVERED 2 PREVIOUS WITNESSES WHICH INDICATE THAT FND. T-IRON IS IN SAME POSITION AS 1987 SURVEY CITED IN SECTION A ABOVE

T-IRON  
ACCEPTED FND. AS BEST AVAILABLE EVIDENCE OF THE ORIGINAL CORNER POSITION

C. Description of monument for corner and accessories established to perpetuate locating the position of the corner:  
L-13 REPLACED FND. T-IRON W/ STD. REMON. MONUMENT STAMPED L 13 T14N R10E  
N02°W, 24.76' SET NAIL W/TAG #37276 IN SW FACE 24" MAPLE  
N35°E, 29.68' SET NAIL W/TAG #37276 IN SE FACE 30" MAPLE  
S12°E, 36.84' SET NAIL W/TAG #37276 IN E. FACE TRIPLE 6" APPLE  
S28°W, 33.79' SET NAIL W/TAG #37276 IN SE FACE 12" ELM

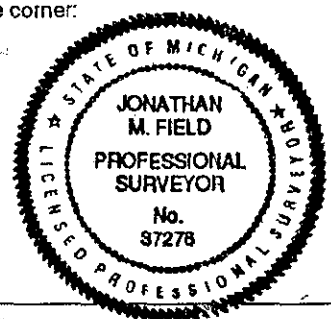

Signed by Jonathan M. Field Date 9-30-97  
Surveyor's Michigan License No. 37276

FORM APPROVED BY MICHIGAN STATE BOARD OF LAND SURVEYORS, JAN. 28, 1971

REVISED MAY 14, 1975  
REVISED JAN., 1973  
ADAPTED FOR WORD PROCESSING MARCH, 1993

APPROVED  
9-29-97  
*11:00 AM*  
*ME*  
*RFB*

SURVEY &  
REMONUMENTATION

NOV 26 1997

COMMISSION

