## SURVEY & REMONUMENTATION

MAR 02 1999

S

S

For corners in: ELMWOOD TWP.

TUSCOLA

1. Public Land Survey

2. Property Controlling

Property in Sec.

in Section 3. Miscellaneous

## 1998 REMONUMENTATION PROGRAM LAND CORNER RECORDATION CERTIFICATE

Filing Requirement of Act 74, Mich. P.A. 1970

RECEIVED FOR RECORD	riO
LIBER NOPAGE NO.#	70
FILE NO. ELM WOOD	IWF

SECTION 98 NOV 20 AM 11: 40

Corner Code #

Gensy Mospier TUSCOLA COUNTY

T 14N R 10E M-3 R R R R

Located In:

Register of Deeds Stamp & File Number

Δ

9

С

7

5

8

1

2

3

Δ .5 DEFGHIJKL

3

10

2

11

1

12

Recorded Plat 4. Lot No. 5. Private Claims 1. JONATHAN M. FIELD , in a field survey on MAY 15 19 98 , do hereby certify that under requirements of P.A. 74, Michigan P.A. of 1970, the corner points mentioned in lines 1 and 2 above were in conformance with regulations and rules therefore as required in the current manual of survey instructions of the United States Department of the Interior, Bureau of Land Management or by a decree of a Court of Law and/or that the corner points mentioned in lines 3, 4 and 5 above were in conformance with the rules of the Michigan Board of Land Surveyors or by a Decree of a Court of Law; established, re-established, monumented, re-monumented, recovered, found as expressed below:

16 15 14 13 17 18 ≅ 22 23 24 19 20 21 26 25 29 28 27 10 30 11 36 35 32 33 34 12 31 NOTE: Not more than 4 corners, all in the same town and range, may be recorded on this certificate.

Description of original monument and accessories and/or subsequent restoration:

1835 GLO; PARKE, D.S.; SET POST; BEECH 14 S31W 27 LKS., HEMLOCK 15 N29W 67 LKS.

1950 BLACK; ROWE WIT CARD; FND PIPE; NORTH 24.8' P/P, N39°W 44.8' 14" MAPLE, S40°W 70.2' NE COR 4X10 CONC

1971 ROWE ENG.; ROWE, P.S. #11192; SURVEY L.1 PG.249; FND 3/8" RE-ROD; S45°E 49.06' NAIL & CAP 14" MAPLE, N40°W 44.51' NAIL & CAP 24" MAPLE, S40°W 51.51' NAIL & CAP IN P/P, NORTH 29.53' FACE TRIANGULAR

1973 ROWE ENG.; ROWE P.S.#11192; LCRC PG.6; SAME OBJECT & WITS AS 1971 ROWE SURVEY CITED ABOVE. 1973 ROWE ENG.; ROWE P.S.#11192; SURVEY L.433 PG.120; SAME OBJECT & WITS AS 1971 ROWE SURVEY CITED

1974 ROWE ENG.; ROWE P.S.#11192; SURVEY L.546 PG.1044; SAME OBJECT & WITS AS 1971 ROWE SURVEY CITED

1974 ROWE ENG.; ROWE P.S.#11192; SURVEY L.443 PG.248-9; SAME OBJECT & WITS AS 1971 ROWE SURVEY CITED

1977 ROWE ENG.; DUNTON P.S.#23503; SURVEY L.474 PG.226-7; SAME OBJECT & WITS AS 1971 ROWE SURVEY

1977 ROWE ENG.; DUNTON P.S.#23503; SURVEY L.474 PG.236-7; SAME OBJECT & WITS AS 1971 ROWE SURVEY

1989 DUNTON LAND SURVEYING; DUNTON P.S.#23503; SURVEY L.608 PG.1122; S45°E 49.06' NAIL & CAP IN 14" MAPLE, N40°W 44.51' NAIL & CAP IN 24" MAPLE, S40°W 51.51 NAIL & CAP IN P/, WEST 2621.83' 3/4" SQ IRON AT 1/4 COR

GLO NOTES FOR T14N-R11E INDICATE THAT THIS CORNER IS COMMON WITH A-3 T14N-R11E

Description of corner evidence found and/or method applied in restoring or reestablishing corner: 1998 ROWE; FIELD, PS#37276; FND 1/2" ROD IN MON. BOX; ON C/L ASPH. ROAD E-W, 3.5' W. OF C/L OF ASPH. ROAD TO S. & ON C/L POWER LINE TO N. RECOVERED 3 PREVIOUS WITS WHICH INDICATE THAT FND ROD IS IN

SAME POSITION AS 1971 SURVEY CITED IN SECTION A ABOVE

ACCEPTED FND ROD AS A CAREFUL AND FAITHFUL PERPETUATION OF THE ORIGINAL CORNER POSITION.

Description of monument for corner and accessories established to perpetuate locating the position of the corner:

M-3 REPLACED FND. ROD W/ 5/8" ROD & STD. REMON. CAP STAMPED M 3 T14N R10E ENCASED IN CONC. IN MON. OF WICH

**BOX** \$45°E, 49.66' SET NAIL W/TAG # 37276 IN NE FACE 14" MAPLE N 57°E, 58.17' SET NAIL W/TAG #37376 IN S FACE 36" MAPLE N01°E, 57.52' SET PK W/TAG #37276 IN E FACE P. POLE N41°W, 44.78' SET NAIL W/TAG #37276 IN NE FACE 30" MAPLE

S42°W, 48.16' TOP CENTER HYDRANT

S22°W, 51.57' FND. NAIL W/BOTTLE CAP IN N FACE P. POLE

37276

11-2-98 Date

No. 37276 AND BORY OVED BY MICHIGAN STATE BO REVISED MAY 14, 1975 REVISED JAM., 1983 ADAPTED FOR WORD PROCESSING MARCH, 1983

JONATHAN

M. FIELD


**PROFESSIONAL** 

SURVEYOR

APPROVED 10-12-88

terestra Signed by\_

Surveyor's Michigan License No.

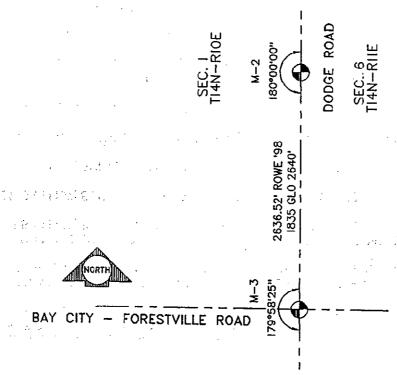

SURVEY & REMONUMENTATION

MAR 02 1999

SECTION