

SURVEY & REMONUMENTATION

MAR 02 1999

**1998 REMONUMENTATION PROGRAM
LAND CORNER RECORDATION CERTIFICATE**

Filing Requirement of Act 74, Mich. P.A. 1970

RECEIVED FOR RECORD
PAGE NO. #50
FILE NO. ELMWOOD TWP
98 NOV 20 AM 11:40

Angie M. DeWitt
TUSCOLA COUNTY
REGISTER OF DEEDS

Register of Deeds Stamp & File Number

For corners in: **SECTION**
ELMWOOD TWP.

TUSCOLA (County)	Located In:	Corner Code #
1. Public Land Survey	T <u>14N</u> R <u>10E</u>	<u>M-5</u>
	T _____ R _____	_____
	T _____ R _____	_____
	T _____ R _____	_____
2. Property Controlling in Section	S _____ T _____ R _____	_____
	S _____ T _____ R _____	_____
3. Miscellaneous Property in Sec.	S _____ T _____ R _____	_____
	S _____ T _____ R _____	_____
4. Lot No. _____ Recorded Plat _____		
5. Private Claims _____		

	A	B	C	D	E	F	G	H	I	J	K	L	M
1													
2	6	5	4	3	2	1							
3													
4	7	8	9	10	11	12							
5													
6	18	17	16	15	14	13							
7													
8	19	20	21	22	23	24							
9													
10	30	29	28	27	26	25							
11													
12	31	32	33	34	35	36							
13													

I, JONATHAN M. FIELD, in a field survey on MAY 15 1998, do hereby certify that under requirements of P.A. 74, Michigan P.A. of 1970, the corner points mentioned in lines 1 and 2 above were in conformance with regulations and rules therefore as required in the current manual of survey instructions of the United States Department of the Interior, Bureau of Land Management or by a decree of a Court of Law and/or that the corner points mentioned in lines 3, 4 and 5 above were in conformance with the rules of the Michigan Board of Land Surveyors or by a Decree of a Court of Law; established, re-established, monumented, re-monumented, recovered, found as expressed below:

NOTE: Not more than 4 corners, all in the same town and range, may be recorded on this certificate.


A. Description of original monument and accessories and/or subsequent restoration:
1835 GLO; PARKE, D.S.; SET POST; HEMLOCK 10 S19W 14 LKS., SUGAR 12 N19W 35 LKS.
1970 ALBRIGHT P.S.# 10057; LCRC PG.13; BOAT SPIKE; S.E. 73.40' T/P, N.W. 35.25' P/P
1975 BECK P.S.#21559; LCRC PG.15; 1/2" RE-ROD SET BY SINGLE PROPORTION MEAS.; N20°W 31.21 RLS 11192 TAG IN P/P, EAST 7.4' C/L 23' PAV'T.; SOUTH 8' +/- REMAINS FENCE WEST.
1984 ROWE ENG.; ROWE P.S.#11192; SURVEY L.546PG.1045; FND RE-ROD; N30°W, 31.05' FND REI BRASS TAG IN SE FACE P/P., EAST 7' +/- C/L PAV'T.

GLO NOTES FOR T14N-R11E INDICATE THAT THIS CORNER IS COMMON WITH A-5 T14N-R11E

B. Description of corner evidence found and/or method applied in restoring or reestablishing corner:
1998 ROWE; FIELD, PS #37276; FND. 1/2" ROD; 7.4' W. OF C/L ASPH ROAD N-S & IN LINE W/ FIELD LINE TO E & TREE ROW TO W, S 8' +/- REMAINS OF FENCE TO W. RECOVERED 2 PREVIOUS WITS WHICH INDICATE THAT FND. ROD IS IN SAME POSITION AS 1975 LCRC CITED IN SECTION A ABOVE

ACCEPTED FND. ROD AS A CAREFUL & FAITHFUL PERPETUATION OF THE ORIGINAL CORNER POSITION

C. Description of monument for corner and accessories established to perpetuate locating the position of the corner:
M-5 REPLACED FND. ROD W/ STD. REMON. MONUMENT & CAP STAMPED M 5 T14N R10E IN MON. BOX
N31°W, 33.69 FND. P-K NAIL W/FLAG. IN NE FACE P. POLE
N44°E, 27.72' SET 1/2" ROD W/CAP #37276
S39°E, 29.92' SET 1/2" ROD W/CAP #37276
S12°W, 28.45' SET 1/2" ROD W/CAP #37276

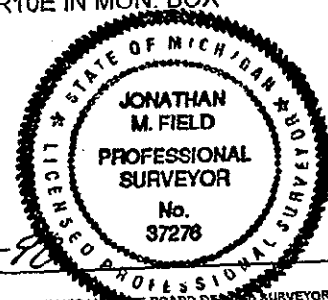

Signed by *Jonathan M. Field*
Surveyor's Michigan License No. 37276

Date 11-2-98

FORM APPROVED BY MICHIGAN BOARD OF LAND SURVEYORS, JAN. 28, 1971

REVISED MAY 14, 1975
REVISED JAN., 1993
ADAPTED FOR WORD PROCESSING MARCH, 1993

APPROVED
10-12-98
[Signature]



SEC. 12
T14N-R10E

M-4
179°55'19"

2639.24' ROWE '98
2639.12' REI '84
1835 GLO 2640'

DODGE ROAD

SEC. 7
T14N-R11E

M-5
179°59'26"

2639.08' ROWE '98
1835 GLO 2640'

DODGE ROAD

SEC. 13
T14N-R10E

M-6
179°52'50"

SEC. 18
T14N-R11E

SURVEY &
REMONUMENTATION

MAR 02 1999

SECTION