MAR 02 1999

**SECTION** 

## 1998 REMONUMENTATION PROGRAM LAND CORNER RECORDATION CERTIFICATE

Filing Requirement of Act 74, Mich. P.A. 1970

RECEIVED FOR RECORD

LIBER NO. PAGE NO #52

FILE NO. ELM WOOD TUP

98 NOV 20 AM 11: 40

For corners in: ELMW	OOD TWP.	!	<b>!</b>		<i></i>	<b>,</b>			
TUSCOLA (County)	Located In:	Corner Code #			G	TUSCO	インつと	Spren UNTY DEEDS	<b>^</b>
Public Land Survey	T <u>14N</u> R <u>10E</u> TR TR	M-7			,	REGIST	ER OF E	)EED'S	
2. Property Controlling In Section	\$TR								
3. Miscellaneous	S T R		Regi	ster of D	eeds S	tamp 8	. File N	umber	
Property in Sec.	S TR					<del></del>		<u></u>	
4. Lot No.	Recorded Plat			, A B	3 D	E F (	э н і	IJĸ	L M
5. Private Claims				2 6	5	4	3	2	1
I,JONATHAN M. FIE	ELD , in a field survey o	on <u>M</u> AY 15_		4 7	8	9	10	11	12
do hereby certify that under	r requirements of P.A. 74, Michigan P.A.	A. of 1970, the corner points t	mentioned	6 18	17	16	15	14	13

do hereby certify that under requirements of P.A. 74, Michigan P.A. of 1970, the corner points mentioned in lines 1 and 2 above were in conformance with regulations and rules therefore as required in the current manual of survey instructions of the United States Department of the Interior, Bureau of Land Management or by a decree of a Court of Law and/or that the corner points mentioned in lines 3, 4 and 5 above were in conformance with the rules of the Michigan Board of Land Surveyors or by a Decree of a Court of Law; established, re-established, monumented, re-monumented, recovered, found as expressed below:

NOTE: Not more than 4 corners, all in the same town and range, may be recorded on this certificate.

1 '		<u> </u>	<u> </u>	<del>-</del> 1	IJK	L M
2	6	5	4	3	2	ì
4 5	• 7	8	9	10	11	12
6 7	18	17	16	15	14	13
8	19	20	21	<sup>11</sup> 22	23	24
, 10   11	30	29	28	27	26	25
12	31	32	33	34	35	36

A. Description of original monument and accessories and/or subsequent restoration:

1835 GLO; PARKE D.S.; SET POST; BEECH 24 S64W 21 LKS.; SUGAR 8 N19W 25 LKS.

1970 ALBRIGHT, P.S.#10057; LCRC PG.13; BOAT SPIKE; NE 30.95' 5" DIA PIPE, SE 43.25' T/P, SW 55.0' P/P, NW 98.92' 24" MAPLE

1976 ROWE ENG.; BECK P.S.#21559; SURVEY L.458 PG.197; 1/2" IRON ROD; NORTH OCCUPIED 1/4 LINE, S70°E 10.54' RLS 11192 TAG IN 8" POPLAR, S25°E 10.49' RLS 11192 TAG IN 7" POPLAR, S30°W 21.84' RLS 11192 TAG IN 8" POPLAR

1982 ROWE WIT CARD; NO OBJECT STATED; \$55°W 70.67' NE COR CONC BASE OF BILL BOX

1983 BOLDT, P.S.#28405; LCRC PG.28; N80°W 98.86' FND NAIL W/ TAG #10057 IN NE FACE 20" MAPLE, \$45°W 54.90' FND NAIL W/ TAG #10057 IN NW FACE P/P, \$45°E 43.26' FND NAIL W/ TAG #10057 IN T/P, N45°E 46.33' SW FACE ROAD SIGN POST.

## GLO NOTES FOR T14N-R11E INDICATE THAT THIS CORNER IS COMMON WITH A-7 T14N-R11E

B. Description of corner evidence found and/or method applied in restoring or reestablishing corner: 1998 ROWE; FIELD, PS#37276; FND. 5/8" ROD 2.5' W. OF C/L ASPH ROAD N-S, 8.0' N. OF C/L ASPH ROAD TO W. & ON C/L GRAVEL ROAD TO E. RECOVERED 1 PREVIOUS WIT. WHICH INDICATES THAT FND. ROD IS IN SAME POSITION AS 1970 LCRC CITED IN SECTION A ABOVE

## ACCEPTED FND ROD AS A CAREFUL & FAITHFUL PERPETUATION OF THE ORIGINAL CORNER POSITION

C. Description of monument for comer and accessories established to perpetuate locating the position of the corner: M-7 REPLACED FND. ROD W/STD. REMON. MONUMENT AND CAP STAMPED M 7 T14N R10E IN MON. BOX

APPROVED 10-12-9ビ

\$21°W, 55.44' FND. P-K NAIL WIFLAG. E. FACE P. POLE

\$42°E, 49.57' TOP CENTER OF PHONE RISER

S53°E, 37.76' SET ROD W/CAP #37276

N08°W, 128.80' FND. P-K NAIL W/FLAG. IN E. FACE OF P. POLE


N45°E, 46.31' CENTER ROAD SIGN

N42°E, 35.48' SET ROD W/CAP #37276

Signed by Emute M Find
Surveyor's Michigan License No. 37276

FORM APPROVED BY MICHIGAN STATE BOARD OF LAND SURVEYORS, JAN. 28, 1971

REVISED MAY 14, 1976 REVISED JAN., 1983 ADAPTED FOR WORD PROCESSING MARCH, 1993

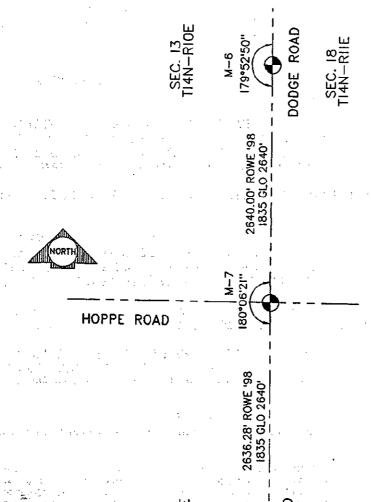

SURVEY & REMONUMENTATION

MAR 02 1999

CECTION