SURVEY & REMONUMENTATION

MAR 02 1999

3. Miscellaneous Property in Sec.

1998 REMONUMENTATION PROGRAM LAND CORNER RECORDATION CERTIFICATE

Filing Requirement of Act 74, Mich. P.A. 1970

RECEIVED FOR RECORD _page no.# LIBER NO. THE NO. ELM WOOD TH

98 DEC - 1 AM 8: 57

For corners in: ELMWOOD TUSCOLA	TWP. Located In:	Corner Code #
(County)		
1. Public Land Survey	T <u>14N</u> R <u>10E</u> TR	<u>M-11</u>
- A Controlling S	TR TR TR	
2. Property Controlling S in Section S	TR	

Register of Deeds Stamp & File Number

4. Lot No, Recorded Plat 5. Private Claims	
5. Private Claims	

I. JONATHAN M. FIELD , in a field survey on MAY 15 19 98 .

do hereby certify that under requirements of P.A. 74, Michigan P.A. of 1970, the corner points mentioned in lines 1 and 2 above were in conformance with regulations and rules therefore as required in the current manual of survey instructions of the United States Department of the Interior, Bureau of Land current manual of survey instructions of the United States Department of the Interior, Bureau of Land 5. current manual of survey instructions of the United States Department of the Interior, Bureau of Land Management or by a decree of a Court of Law and/or that the corner points mentioned in lines 3, 4 and 5 above were in conformance with the rules of the Michigan Board of Land Surveyors or by a Decree of a court of Law; established, re-established, monumented, re-monumented, recovered, found as expressed below:

NOTE: Not more than 4 corners, all in the same town and range, may be recorded on this certificate.

, A	вС	: D E	FG	, н (JK	L M	
2	6	5	4	3	2	1	
3 4	. 7	8	9	10	11	12	
5 6	18	17	16	15	14	13	
7 8	19	20	21	22	23	24	
9 10	30	29	28	27	26	25	
11 12		32	33	34	35	36	
13		ــــــــــــــــــــــــــــــــــــــ			_L	<u></u>	

A. Description of original monument and accessories and/or subsequent restoration:
1835 GLO; PARKE D.S.; SET POST; HEMLOCK 22 S65W 12 LKS., SUGAR 15 N5W 13 1/2 LKS.
1975 R.S. SCOTT FOR T.C.R.C.; DODGE ROAD PLANS ELMWOOD ROAD TO M-81; SET P-K NAIL; N35W 68.00' P.POLE

GLO NOTES FOR T14N-R11E INDICATE THAT THIS CORNER IS COMMON WITH A-11 T14N-R11E

B. Description of corner evidence found and/or method applied in restoring or reestablishing corner:

1998 ROWE; FIELD, PS #37276; FND. NO EVIDENCE OF MONUMENT AT CORNER POSITION; REESTABLISHED CORNER POSITION BY PROPORTION OF R.S. SCOTT DISTANCES BY STATIONING & EXTENDING LINE FROM M-12 T14N-R10E THROUGH FND. NAIL ON SEC, LINE (PER T.C.R.C.) 1346'± N OF M-12. CORNER POSITION THUS REESTABLISHED FALLS ON C/L OF DODGE ROAD N-S & 0.7' S. OF C/L M-81 E-W.

ACCEPTED PROPORTION AS BEST REESTABLISHMENT OF THE ORIGINAL CORNER POSITION

C. Description of monument for corner and accessories established to perpetuate locating the position of the corner: M-11 SET STD. REMON. MONUMENT & CAP STAMPED M 11 T14N R10E IN MON. BOX

N16°E, 60.22' SET P-K NAIL IN ASPH.

N32°W, 69.67' FND. NAIL W/ MSHD TAG IN P.POLE

N70°W, 167.98' FND. NAIL W/ MSHD TAG IN P.POLE \$71°W, 155.54' FND. NAIL W/ MSHD TAG IN 15" MAPLE

N60°E, 46.49' SET 1/2" ROD W/ CAP #37276

N40°E, 53.51' SET 1/2" ROD W/ CAP #37276

NAHTAHOL M. FIELD PROFESSIONAL SURVEYOR 40165


Signed by Surveyor's Michigan License No.

Date

1-26-98

ORM APPROVED BY NICHIGAM STATE BOARD OF LAND SURVEYORS, JAN. 24, 1974 REVISED MAY 14, 4375 REVISED JAN., 1433 ADAPTED FOR WORD PROCESSING MARCH, 1833

APPROVED

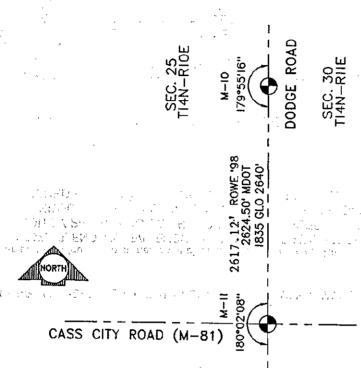

SURVEY &

MAR 0 2 1999

SECTION