MAR 0 2 1999

For corners in:

Lot No.

5. Private Claims

THECOLA

1998 REMONUMENTATION PROGRAM LAND CORNER RECORDATION CERTIFICATE

SECTION Filing Requirement of Act 74. Mich. P.A. 1970

RECEIVED FOR RECORD LIBER NO. ____PAGE NO \$\frac{1}{2}50 FILE NO. ELKLAND TWP

ELKLAND TWP.

TOSCOLA	Localed in.	Comer Code #	
(County)			
Public Land Survey	T <u>14N</u> R <u>11E</u> T R T R T R	A-6	
2. Property Controlling in Section	S T R S T R		
Miscellaneous Property in Sec.	S T R S T R		

. Recorded Plat

98 NOV 20 AM 11: 40

Register of Deeds Stamp & File Number

, JONATHAN M. FIELD	, in a field survey on _	MAY 15	19 <u>98</u> ,
io hereby certify that under requirements of	FP.A. 74, Michigan P.A. of	1970, the come	er points mentioned
n lines 1 and 2 above were in conformant	ce with regulations and r	ules therefore	as required in the
current manual of survey instructions of the	United States Departmen	t of the interio	r. Bureau of Land
Management or by a decree of a Court of Lav	w and/or that the corner o	oints mentioned	lin lines 3 4 and 5
above were in conformance with the rules of	of the Michigan Board of L	and Surveyors	or by a Decree of a
Court of Law; established, re-established	ed, monumented, re-mor	numented, rec	overed, found as

NOTE: Not more than 4 corners, all in the same town and range, may be recorded on this certificate.

1 1	A B (C D	E F (3 H	IJK	L M
2	6	5	4	3	2	1
4	. 7	8	9	10	11	12
5 6 7	18	17	16	15	14	13
8 9	19	20	21	22	23	24
10	30	29	28	27	26	25
11	31	32	33	34	35	36

Description of original monument and accessories and/or subsequent restoration:

1835 GLO; PARKE D.S.; SET AS M-6 T14N-R10E; 1/4 SEC. POST; LYNN 8 S15W 16 LKS., BEECH 6 N30W 32 LKS. 1970 ALBRIGHT; LCRC PG.13; 5/8" RE-ROD; ESE 74.13' DEAD END RD SIGN, SSE 42.72' T/P, WEST 23.65' RD SIGN POST, NW 25.82' P/P

1971 TCRC; ROWE WIT CARD; FND 1/2" ROD; WNW 25.1' FACE P/P, NW 118.5' SE COR OF TRL CONC SLAB, SE 42.5' FACE T/P

1975 BECK P.S.#21559; LCRC PG.15; SET1/2" RE-ROD FROM REMAINING 1971 WITS; N40°W 118.50' SE COR CONC SLAB AT MOBILE HOME, S80°W 25.58' RLS 11192 TAG IN P/P, S25°W 52.87' RLS 11192 TAG IN P/P, S60°E 52.14' RLS 11192 TAG IN T/P

3LO NOTES FOR T14N-R11E IMPLY THAT THIS CORNER IS COMMON WITH M-6 T14N-R10E

3. Description of corner evidence found and/or method applied in restoring or reestablishing corner: 1998 ROWE; FIELD, PS #37276; FND. 1/2" ROD ON C/L GRAVEL ROAD TO E. & IN LINE W/ POWER LINE/FIELD LINE TO W & 1.5' W. OF C/L ASPH. ROAD N-S. RECOVERED 2 PREVIOUS WITS WHICH INDICATE THAT FND. ROD IS IN SAME POSITION AS 1975 LCRC CITED IN SECTION A ABOVE

ACCEPTED FND. ROD AS A CAREFUL & FAITHFUL PERPETUATION OF THE ORIGINAL CORNER POSITION

Description of monument for corner and accessories established to perpetuate locating the position of the corner: 1-6 REPLACED FND. ROD W/ STD. REMON. MONUMENT & CAP STAMPED M 6 T14N R10E IN MON. BOX

FND. PK W/FLAGGING NE FACE P. POLE

N66°E, 41.46' CENTER ROAD SIGN POST

N42°E, 48.24' SET 1/2" ROD W/CAP #37276

S58°E, 51.44' TOP CENTER OF PHONE RISER

S71°W, 25.95' FND P-K NAIL W/FLAG. IN N FACE OF P. POLE

S69°W, 25.54' FND. NAIL W/TAG #11192 IN NE FACE OF P. POLE

S27°W, 53.61' FND. P-K NAIL W/FLAG. IN SE FACE OF P. POLE

S29°W, 52.87' FND. NAIL W/TAG #11192 IN NE FACE OF P. POLE

JONATHAN M. FIELD POFESSIONAL SURVEYOR 37278 POFESSI


Signed by Burveyor's Michigan License No. 37276

Date

OVED BY MICHIGAN STATE BOARD OF LAND SURVEYORS, JAN. 28, 1971

REVISED MAY 14, 1976 REVISED JAN., 1983 ADAPTED FOR WORD PROCESSING MARCH, 1993

APPROVED -19-98

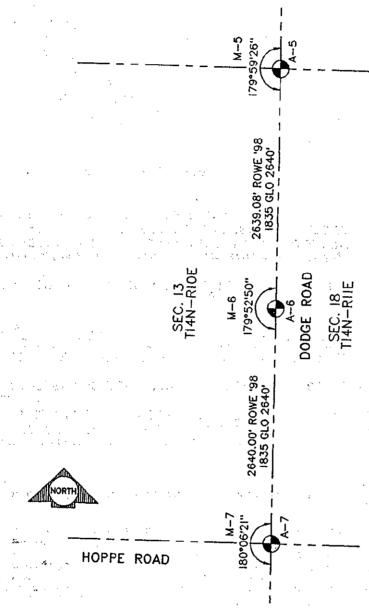

SURVEY &

MAR 02 1999

SECTION