WAR 0 2 1999

SECTION

1998 REMONUMENTATION PROGRAM LAND CORNER RECORDATION CERTIFICATE

Filing Requirement of Act 74, Mich. P.A. 1970

RECEIVE	FOR RECORD
LIBER NO.	PAGENO. 51
THE HOLE	LKLAND TWP

98 NOV 20 AM II: 40

_ ; , ,		:		
or corners	in:	٠.	ELKLAND TWP.	

2. Property Controlling in Section

Miscellaneous Property in Sec.

TUSCOLA Located In: T14N R11E 1. Public Land Survey

Corner Code #

Register of Deeds Stamp & File Number

Recorded Plat Private Claims

<u>JONATHAN M. FIELD</u> in a field survey on to hereby certify that under requirements of P.A. 74, Michigan P.A. of 1970, the corner points mentioned n lines 1 and 2 above were in conformance with regulations and rules therefore as required in the surrent manual of survey instructions of the United States Department of the Interior, Bureau of Land vianagement or by a decree of a Court of Law and/or that the corner points mentioned in lines 3, 4 and 5 above were in conformance with the rules of the Michigan Board of Land Surveyors or by a Decree of a Court of Law; established, re-established, monumented, re-monumented, recovered, found as expressed below:

NOTE: Not more than 4 corners, all in the same town and range, may be recorded on this certificate.

1	A B (C D	E · F · C	э H €	JΚ	LN
2	6	5	4	3	2	1
4	7	8	9	10	11	12
5	18	- 17	16	15	14	13
8	19	20	21	⁷⁷ 22	23	24
9 10	30	29	28	27	26	25
11 12	31	32	33	34	35	36

Description of original monument and accessories and/or subsequent restoration:

1835 GLO; PARKE D.S.; SET AS M-7 T14N-R10E; POST; BEECH 24 S64W 21 LKS.; SUGAR 8 N19W 25 LKS. 1970 ALBRIGHT, P.S.#10057; LCRC PG.13; BOAT SPIKE; NE 30.95' 5" DIA PIPE, SE 43.25' T/P, SW 55.0' P/P, NW 98.92' **24" MAPLE**

1976 ROWE ENG.; BECK P.S.#21559; SURVEY L.458 PG.197; 1/2" IRON ROD; NORTH OCCUPIED 1/4 LINE, S70°E 10.54' RLS 11192 TAG IN 8" POPLAR, S25°E 10.49' RLS 11192 TAG IN 7" POPLAR, S30°W 21.84' RLS 11192 TAG IN 8"

1982 ROWE WIT CARD, NO OBJECT STATED; S55°W 70.67' NE COR CONC BASE OF BILL BOX

1983 BOLDT, P.S.#28405; LCRC PG.28; N80°W 98.86' FND NAIL W/ TAG #10057 IN NE FACE 20" MAPLE, S45°W 54.90' FND NAIL W/ TAG #10057 IN NW FACE P/P, S45°E 43.26' FND NAIL W/ TAG #10057 IN T/P, N45°E 46.33' SW **FACE ROAD** SIGN POST.

3LO NOTES FOR T14N-R11E INDICATE THAT THIS CORNER IS COMMON WITH M-7 T14N-R10E

Description of corner evidence found and/or method applied in restoring or reestablishing corner: 1998 ROWE; FIELD, PS#37276; FND. 5/8" ROD 2.5' W. OF C/L ASPH ROAD N-S, 8.0' N. OF C/L ASPH ROAD TO W. & ON C/L GRAVEL ROAD TO E. RECOVERED 1 PREVIOUS WIT, WHICH INDICATES THAT FND. ROD IS IN SAME POSITION AS 1970 LCRC CITED IN SECTION A ABOVE

ACCEPTED FND ROD AS A CAREFUL & FAITHFUL PERPETUATION OF THE ORIGINAL CORNER POSITION

Description of monument for corner and accessories established to perpetuate locating the position of the corner:
₹-7 REPLACED FND. ROD W/ STD. REMON. MONUMENT AND CAP STAMPED M 7 T14N R10E IN MON. BOX

S21°W, 55.44' FND. P-K NAIL W/FLAG, E. FACE P. POLE S42°E, 49.57' TOP CENTER OF PHONE RISER S53°E, 37.76' SET ROD W/CAP #37276

N08°W, 128.80' FND, P-K NAIL W/FLAG, IN E, FACE OF P, POLE

N45°E, 46.31' CENTER ROAD SIGN

N42°E, 35.48' SET ROD W/CAP #37276

JONATHAN M. FIELD ROFESSIONAL SURVEYOR **97276** POFESSI


OF MICH

Signed by Surveyor's Michigan License No. 37276

11-2-98 Date

REVISED MAY 14, 197 REVISED JAN., 1983 ADAPTED FOR WORD PROCESSING MARCH, 1983

<u>APPROVED</u> -19-90

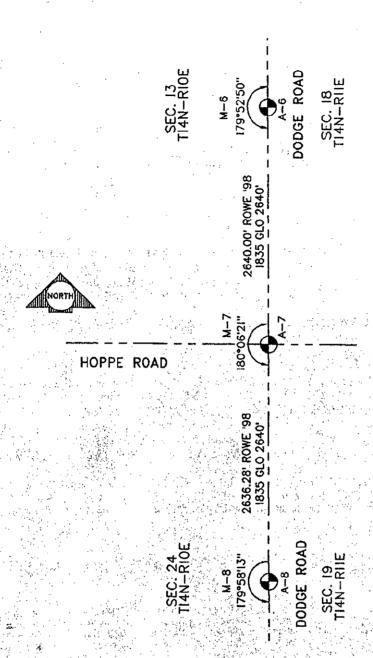

SURVEY & REMONUMENTATION

MAR 0.2 1999

SECTION