



Filing Requirement of Act 74, Mich. P.A. 1970

LAND CORNER RECORDATION CERTIFICATE

REGEIVED FOR RECORD PAGE NO.#66 FIKIAnd

For corners in Elkland Twp.				- 2000	CU AN	1 8: 5	5
Tuscola (County)	Located In:	Corner Code #		Gray-	げつじ	Serv	~~
Property Controlling in Section Miscellaneous Property in Sec.	TR_		Registe	TUSCO REGIST!			
A. Lot No, Recorded Plat		A B C 2 6 3		G H I		K L	
conformance with regulations and rules therefore as required in the current manual of survey instructions of the United States Department of the Interior, Bureau of Land Management or by a decree of a Court of Law and for that the corner points mentioned in lines 3, 4 and 5 above were in conformance with the rules of the Michigan Board of Land Surveyors or by a Decree of a Court of Law; established, re-established, monumented, recovered, found as expressed below:			he 5/or 6 18	17 16	15	—14— —23—	-13-
NOTE: Not more than 2 corr on this certificate.	ners, all in the same town	n and range, may be recorded	9 10—30— 11 12—31—	-2928	2734	-26- -35-	25 36
A. Description of original mo	nument and accessorie	es and/or subsequent restoration:	131			1	
		R 12 N25W 8-1/2, CEDAR 9 N41E 5,					

- B. Description of corner evidence found and/or method applied in restoring or reestablishing corner:
- EMERY, PS#24593; FOUND SHAFT; FOUND NO PREVIOUS MONUMENTS OR ACCESSORIES; DISTANCES TO CORNERS 1999 B-13 AND D-13 INDICATE THAT FOUND SHAFT IS IN GOOD AGREEMENT WITH PROPORTIONATE SPLIT.

ACCEPTED FOUND SHAFT AS BEST AVAILABLE EVIDENCE OF ORIGINAL CORNER POSITION.

C-13
SET STD. REMON. MONUMENT STAMPED C 13, T14N R11E.
N50°E, 43.34', TOP CENTER OF GAS PIPELINE MARKER
S40°E, 48.56', NW EDGE OF BURIED CABLE SIGN POST
S40°W, 46.34' SET REMON. TAG IN 6X6 WOOD POST
N10°W, 64.64, FACE OF STEEL PIPE SIGN POST


DUE TO THE UNTIMELY ILLNESS OF MR. LIONEL ROY EMERY, I, KARIM. LOHELA, HAVE REVIEWED HIS FIELD NOTES AND PREPARED THIS FORM FOR PEER GROUP REVIEW

PREPARED THIS FORM FOR PEER GROUP REVIEW

Signed by 12 Surveyor's Michigan License No.

FORM APPROVED BY MICHIGAN STATE BOARD OF PROFESSIONAL SURVEYORS, JAN. 28, 1971

REVISED MAY 14,1975 REVISED JAN., 1983 REVISED OCT., 1995

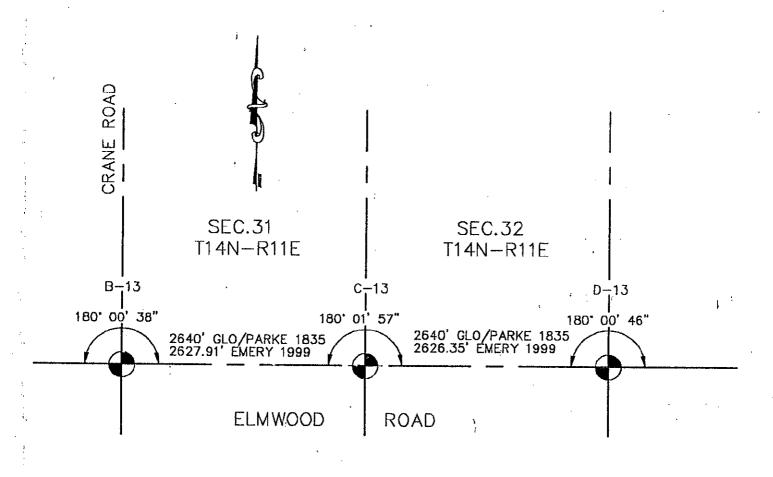

SEC.6 T13N-R11E SEC.5 T13N-R11E