


1999 REMONUMENTATION PROGRAM

LAND CORNER RECORDATION CERTIFICATE

RECEIVED	FOR RECORD
LIBER NO	- PAGE NO #65
EILE 110. E	Kland Tup
	1

Car		Fili	ng Requirement of Act 7	74, Mich. P.A. 19	70	-99 DEC	20 A	M O.	ሳሮ .
	ners in Elkland f	_				20 DEG	CU N	11 ()1	23
_ Tus	(County)	Located in:	Corner Code #			Gray	ーブソン	PpA	\sim
1. Pub	lic Land Survey	T <u>14N</u> R T R T R			•	TUSĆ Regis	CLA CO	UNTY DEEDS	1
in So 3. Misc	perty Controlling ection cellaneous perty in Sec.	TR S TR S TR S TR S TR			Register	of Deeds S	toms & :	Eile Ab	ımhar
				<u> </u>	register	or Deeds 3	rampor	THE ING	mper
4. Lot i	No, Record ate Claims	ded Plat			A B C	DEF	3 H 1	I J 1	KLN
					2 6	54	 3		-
l. Lio	nel Rov Emerv .	in a field survey on	<u>July 5</u> , 19 99do here	shvætete thet inder	3				
requirem	ents of P.A. 74, Michiga	n P.A. of 1970, the com-	er points mentioned in lines 1 ared in the current manual of survey	nd 2 above were in	5		10	—11— —————————————————————————————————	12
United \$!	lates Department of the Ir	nterior, Bureau of Land M	fanagement or by a decree of a C were in conformance with the ru	Court of Law and for	6 18	17——16—	—1,5—	14	13-
Board of	Land Surveyors or by d, found as expressed bel	a Decree of a Court of	of Law; established, re-establish	hed, monumented,	7				
NOTE:	•		n and range, may be recorded	al .	8 19	20 21	22	23	24
	on this certificate.	oro, or as are control to the	ir and range, may be recorded	u	1030	29——28—	27	—2 6 —	25
					11			_	
					12 31	3233	—34—i	35	—36— —
1835 1987	CASE SURVEYING;	CASE, PS#15399; SUR	883E 2, CEDAR 16 N35-1/2\ VEY L. 577 P. 45; FOUND 1/ E 35.81' PK NAIL N. SIDE 8"	/2"IRON; N35E 51.1	7 CENTER BU	RIED GAS L	INE MA	RKER I	POST,
B. Des	cription of corner evide	ence found and/or me	ethod applied in restoring or r	reestablishing corn	er:				
1999 .	WITHIN 0.5' OF FOU	ND 1/2" IRON; FOUN	QUESTIONABLE ACCESS ND 1/2" IRON IS IN GOOD A , AND WITH PROPORTION	GREEMENT WIT					
	ACCEPTED FOUND	1/2" IRON AS BEST A	AVAILABLE EVIDENCE OF	ORIGINAL CORN	IER POSITION				i
						Ju.	<i></i>	litter.	
•	ription of monument fo	or corner and accesso	ories established to perpetua	te locating the pos	ition of the corr	er: William	OF M	CHI	Way.
N45°E, 9 835°E, 4 850°W, N60°W,	D. REMON, MONUME 94.00', SET REMON, T 19.40', SET REMON, T 46.60', SET REMON, T 60.03', SET REMON, T 42.35', FOUND SPIKE	'AG IN SE FACE OF V AG IN SW FACE OF V IAG IN NW FACE OF IAG IN NE FACE OF	WOOD FENCE CORNER PO WOOD POST 6 6X6 WOOD POST 24" PINE	ST		LOEVSE PE	KARI I LOHEL OFESSI SURVEY NO. 44289	M. A ONAL OR S	MINIMUM MANAGER OF STATES
	THE UNTIMELY ILLI		L ROY EMERY, I, KARI M. I				Minnin ES AND	PREPA	4RED
Signed by	·	1. CC		Datet	2/13/0	99			
SURVOVOR	e Michigen License Ma	<u>. λλ</u> 290							

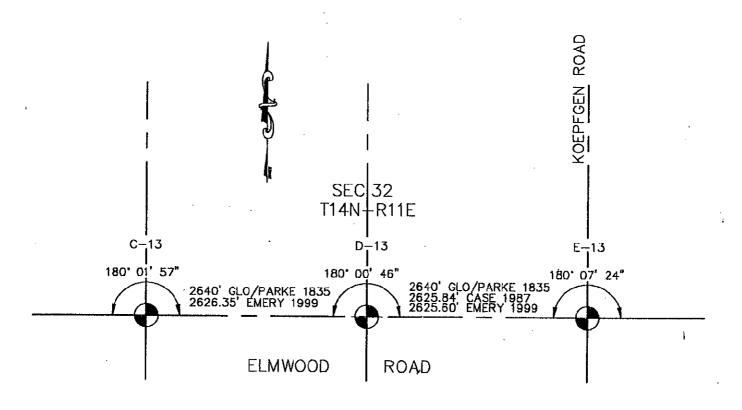

SEC.6 T13N-R11E