

1999 REMONUMENTATION PROGRAM


LAND CORNER RECORDATION CERTIFICATE

RECEIVED FOR RECORD
LIBER NO. EIKland Tup

99 DEC 20 AM 8: 25

FORM APPROVED BY MICHIGAN STATE BOARD OF PROFESSIONAL SURVEYORS, JAN. 28, 1971 REVISED MAY 14,1975 REVISED JAN., 1983 REVISED OCT., 1985

| _ | | Filir | ng Requirement of Act 74, | Mich. P.A. 1970 | - | | in the single | | | | | |
|---|---|--|--|-----------------------|---------|----------|---------------------|--------------------|-------------------------------------|---------------|--|---------------|
| | ners in Elkland | Iwp. Located In: | | 1 | 1 | an | آسي | 770 | San. | · 🔷 . | | |
| Tus | | TUSCOLA COUNTY REGISTER OF DEEDS | | | | | | | | | | |
| 1. Pub | lic Land Survey | T <u>14N</u> R TR TR | | | | | | | | | | |
| in Se | perty Controlling ection cellaneous perty in Sec. | T_R S_ T_R S_ T_R S_ T_R S_ T_R | | · | Dec | viatar . | uf Duna | 4m C4m | 0 | ru. | N 4 | b.a.s |
| | | | | L | Ke | jister | of Deed | is Sta | ımp & | rife | Num | ber |
| 4. Lot i 5. Priva | No , Reco ate Claims | rded Plat | | | A 8 | Ç | D E | F G | н | I J | ĸ | L M |
| | | | : | | 1 1 | ; | 5 | 4- | _ } _ ³— | - 2 | | |
| I, <u>Lionel Roy Emery</u> , in a field survey on <u>July 5</u> , 19 99 do hereby state that under requirements of P.A. 74, Michigan P.A. of 1970, the corner points mentioned in lines 1 and 2 above were in conformance with regulations and rules therefore as required in the current manual of survey instructions of the United States Department of the Interior, Bureau of Land Management or by a decree of a Court of Law and for that the corner points mentioned in lines 3, 4 and 5 above were in conformance with the rules of the Michigan Board of Land Surveyors or by a Decree of a Court of Law; established, re-established, monumented, recovered, found as expressed below: | | | | | |) | 17 | 9 16 21 | -10- -15- -22- | 11 | | -12 |
| NOTE: | Not more than 2 corr on this certificate. | ners, all in the same tow | n and range, may be recorded | 9 | | | | | | | + | |
| | on the centicate. | | | 10 | | | | 28-1 | _2/ | 1 26 | 1 | -25- |
| | | | | 12 | \perp | | 32 | 33. | _34 | 35 | + | -36 |
| B. Des | | | ethod applied in restoring or rec ECOVERED 2 PREVIOUS ACC | | H INC |)ICATI | E THAT | FOU | ND 1/ | /2" 1R | ON I | S IN |
| 1227 | SAME POSITION A | S 1987 CASE SURVEY | CITED ABOVE. | 1 | | | | | | | | |
| | ACCEPTED FOUNI |) 1/2" IRON AS BEST . | AVAILABLE EVIDENCE OF C | RIGINAL CORNER | POS | IIION | | | | | | |
| | | | | | | | , si | _{HHI} III | grun QF / | Willy MiCy | MANA | à |
| C. Desc | cription of monument | for corner and access | ories established to perpetuate | locating the position | n of th | ne cori | ner: All | √ | KARI | М. | G. | |
| E-13 SET ST. N60°E, SOUTH S55°W, N40°W, | D. REMON. MONUM 56.73', SET REMON. I, 26.12', SET REMON 32.83' FACE OF STE , 65.40', SOUTH EDGI | ENT STAMPED E 13, TAG ON TOP OF FEN . TAG IN W FACE OF EL PIPE ROAD SIGN I E OF BURIED CABLE | TI4N RITE. TI4N RITE. ICE CORNER POST NEXT TO UTILITY POLE ABOVE FOUN POST SIGN POST | FOUND NAIL ND NAIL | | ٠ | CLOENSE CHIMINATURE | PROP | LOHE OFESS URVE NO 4421 | SION/ YOR | IIIIIIIIIIIIIIIIIIIIIIIIIIIIIIIIIIIIII | MINITAL STORY |
| THIS FO | ORM FOR PEER GRO | OUP REVIEW | L ROY EMERY, I, KARI M. LO | OHELA, HAVE REV | EWE | D HIS | FIELD | HON | es an | nuw DPR | EPAI | RED |
| Signed b | y Kin | W. La. No. 44289 | | Date 17/ | /17 | 19 | 9 | | | | | |
| Surveyo | r's Michigan License I | | | | | | | | | | | |
| | | ₽ PEI | ROVED (SE) | | | | | | | | | |

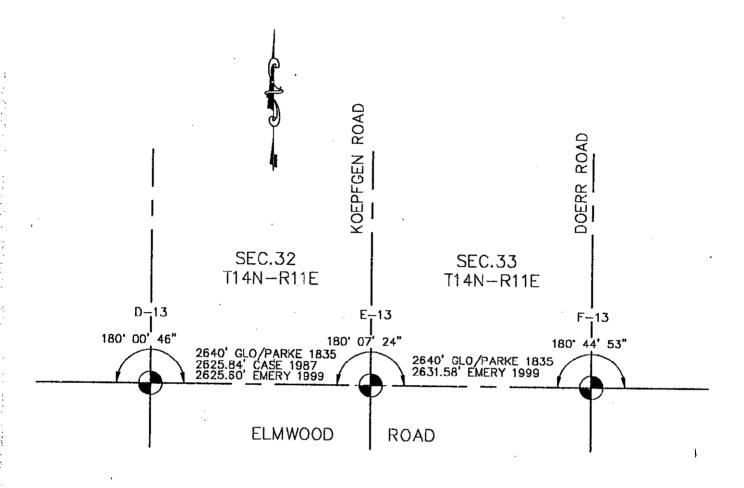

SEC.5 T13N-R11E

SEC.4 T13N-R11E

BIANNI