


## 1999 REMONUMENTATION PROGRAM

LIBER NO. FIKION RECORD TUP.

ONAL SURVEYORS, JAN. 28, 1971 REVISED MAY 14,1975 REVISED JAN., 1983 REVISED OCT., 1995

	LAND	CORNER RECORDA	TION CERTIFICA	TE 99 DEC 20	AM 8: 25	
For corners in Elkland	Twp.	ig Requirement of Act	4, Mich. P.A. 197			
Tuscola (County)	Located In:	Corner Code #		Group-TY		
1. Public Land Survey	T <u>14N</u> R <u>1</u> T R_ T R			भइमाहरहरू <b>इ</b>	F 19#90\$	
Property Controlling in Section     Miscellaneous Property in Sec.	TR ST_R ST_R ST_R ST_R			Register of Deeds	Stamp & File	Number
4. Lot No, Recor	rded Plat			ABCDEF		· · ·
5. Private Claims				2 6 5 4	32	
I, <u>Lionel Roy Emery</u> requirements of P.A. 74, Michiga conformance with regulations and United States Department of the I that the corner points mentioned Board of Land Surveyors or by recovered, found as expressed be	an P.A. of 1970, the come rules therefore as required interior, Bureau of Land Mi in lines 3, 4 and 5 above v a Decree of a Court of	er points mentioned in lines 1 a d in the current manual of surve anagement or by a decree of a 0 were in conformance with the n	nd 2 above were in y instructions of the Court of Law and /or	4 - 7 - 8 - 9 5 - 18 - 17 - 16 7 - 19 - 20 - 21	15 14	13-
NOTE: Not more than 2 corr on this certificate,	ers, all in the same towr	n and range, may be recorde	đ	9 10 30 29 28 11 12 31 32 33	27- 26	
1835 GLO; PARKE, D.S.; SE 1972 CASE, PS#15399; SURV DURING ROAD CONS 1973 CASE SURVEYING; CA 1974 CASE SURVEYING; CA 1976 CASE SURVEYING; CA 1992 CASE SURVEYING; CA N. LEG DIR. SIGN, NSS	ÆY L. 1 P. 617; NO ACC FRUCTION. ASE, PS#15399; SUR VE ASE, PS#15399; SUR VE ASE, PS#15399; SUR VE ASE PS#15399; SUR VE	ESSORIES OR OBJECT ST. Y L. 436 P. 407; SAME NOT EY L. 446 P. 938; SAME NO EY L. 461 P. 716; SAME NO Y L. 633 P. 1025-1026; FOU	ATED FOR CORNER TE FOR CORNER F- I'E FOR CORNER F- I'E FOR CORNER F-	13 AS IN 1972 CASE S 13 AS IN 1972 CASE S -13 AS IN 1972 CASE S	URVEY CITED URVEY CITED	ABOVE ABOVE
B. Description of corner evid 1999 EMERY, PS#24593; FO AGREEMENT WITH C	UND 1/2" IRON IN 3/4"	PIPE; NO RELIABLE ACC	reestablishing corne ESSORIES RECOVE	r: ERED; FOUND 1/2" IRC	)n is in reas	ONABLE
ACCEPTED FOUND 1/2	2" IRON AS BEST AVA	ALABLE EVIDENCE OF O	RIGINAL CORNER I	POSITION.		,
C. Description of monument of F-13 SET STD. REMON. MONUM N45°E, 48.56', SET REMONS20°E, 76.72', SET REMONS45°W, 46.70', SET REMON60°W, 70.21', SET REMONDUE TO THE UNITIME VI	IMENT STAMPED F N. TAG IN SE FACE N. TAG IN W FACE ( N. TAG IN NW FAC IN. TAG IN NE FACI	' 13, T14N R11E. OF UTILITY POLE ABO OF 10" ELM E OF UTILITY POLE AI E OF 16" ELM	OVE FOUND NAII	LICENSON PRO	KARI M. KARI M. KARI M. KARI M. LOHELA DIFESSIONAL URVEYOR NO. 44289	THINIMINIMINIMINIMINIMINIMINIMINIMINIMINI
PREPARED THIS FORM F					rield NOT	es and
			Date 172	113/99		
Surveyor's Michigan License N		PROVED 1500		•		
	f					

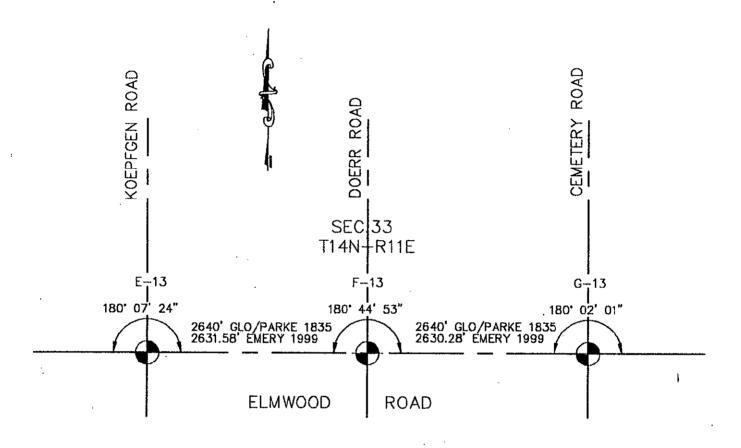

SEC.4 T13N-R11E