

*


1999 REMONUMENTATION PROGRAM

LAND CORNER RECORDATION CERTIFICATE

RECEIVED FOR RECORD, LIBER NO. ENGLENO HO!

99 DEC 20 AM 8: 24

For corners in	Elkland Twp	. Find	Requirement of Act /4	, Mich. P.A. 197		199m on 8' s 4 ³	
Tusco	•	ocated in:	Corner Code #			MINISTERAL TERRETARY	
2. Property C in Section 3. Miscelland Property in	Controlling S Seous S	T <u>14N</u> R <u>111</u> T R T R T R T R T R T R T R T R	E H-13				
,					Register of De	eds Stamp & F	le Number
I, Lionel I requirements of conformance with United States Do that the corner	Roy Emery , in P.A. 74, Michigan P.A. h regulations and rules epartment of the Interior points mentioned in line	a field survey on Ju., of 1970, the corner put therefore as required in the Bureau of Land Mana, s. 3, 4 and 5 above were	11y 7 , 19 99 do hereby oints mentioned in lines 1 and the current manual of survey is germent or by a decree of a Core in conformance with the rules.	2 above were in nstructions of the urt of Law and /or s of the Michigan	A B C D E 2 6 5 3 4 7 8 5 6 18 17	F G H I	J K L
Board of Land	Surveyors or by a De las expressed below:	cree of a Court of La	w; established, re-establishe	d, monumented,	7 20 20	-2122	-2324-
	nore than 2 comers, a is certificate.	il in the same town ar	nd range, may be recorded		9	-28 -27	-2625- -3536-
A. Description	n of original monume	nt and accessories a	and/or subsequent restorat	ion:	131 1 1 1		
1994 ROW IN S I POPL	E ENGINEERING; F FACE 14" ELM; S28 .AR, S85E 98.37' NW	IELD, PS#37276; SU E 46.55' NAIL W/TA CORNER OF GARA	7 N73-1/2W 36, HEMLOCK RVEY L. 662 P. 190-191; S G #37276 IN NE FACE 12 AGE, EAST 59.45' 1/2" ROI	ET 1/2" ROD W/ C " POPLAR, S 42E D W/CAP #37276.	54.54' NAIL W/TA	.G #37276 IN SI	FAG #37276 E FACE 12"
CA.	1985 GRAVLIN, PS#	235 (U; UNRECURDED	SURVEY IN SEC. 34; NO ME	NTION OF OBJECT ,	OR ACCESSSORIES		
					,		•
1999 EMEH IRON DIS	RY, PS#24593; FOUN IS IN SAME POSITI TANCE TO CORNER I	ID 1/2" IRON W/CAP ON AS 1994 ROWE : -13 IS IN EXCELLENT	d applied in restoring or red #37276; RECOVERED 3 PR SURVEY CITED ABOVE. AGREEMENT WITH CA. 198 JLABLE EVIDENCE OF C	EVIOUS ACCESSO	ORIES WHICH IND Y CITED ABOVE.	DICATE THAT F	'OUND 1/2"
			•				ŧ
C. Description	of monument for co	ner and accessories	established to perpetuate	locating the position	on of the corporation	OF MICAY	Manager 1
H-13 SET STD. REM NORTH, 0.5' SI EAST, 59.45', F S85°E, 98.37', N S28°E, 46.55', F S70°W, 49.26',	ION. MONUMENT : ET CARSONITE WIT OUND 1/2" REBAR W CORNER OF GA FOUND NAIL & TAC SET REMON. TAG I	STAMPED H13, T14 NESS POST W/CAP #37276 RAGE 3 #37276 IN NE FACI N SE FACE OF 6" PO	established to perpetuate N R11E E OF 16" COTTONWOOD DPLAR	·	S. LICENSCHILLINGS CO.	KARI M. LOHELA ROFESSIONAL SURVEYOR NO. 44289	MINIMUM CONTRACTOR OF A CONTRA
DUE TO THE U	INTIMELY ILLNESS OR PEER GROUP RE	OF MR. LIONEL RO VIEW	Y EMERY, I, KARI M. LO			<i>*/////</i> ///////////////////////////////	:
Signed by	feel do	1.6h		Date	2/15/99		
Surveyor's Michi	igan License No	44289					

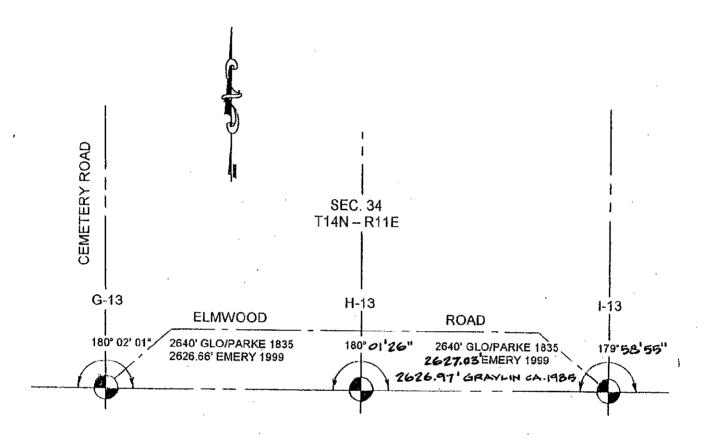

SEC. 3 T13N - R11E

À