

1999 REMONUMENTATION PROGRAM

LAND CORNER RECORDATION CERTIFICAT
Filing Requirement of Act 74, Mich. P.A. 1970

RECEIVED FOR RECORD -PAGE NO #60 THE NO. Elkland Twp 99 DEC 20 ALL

For corners in Elkland	Finng Twp.	Requirement of Act 74, Mich.	0 20
Tuscola (County)	Located In:	Corner Code #	TUSCOLA COUNTY REGISTER COUNTY
1. Public Land Survey	T <u>14N</u> R <u>1.</u> T R T R	<u>IE I-13</u>	REGISTES CY DEEDS
Property Controlling in Section Miscellaneous Property in Sec.	TR_ STR_ STR_ STR_ STR_		Register of Deeds Stamp & File Number
4. Lot No, Reco 5. Private Claims	rded Plat		A B C D E F G H I J K L 2 6 5 4 3 2 1-

I. Lionel Roy Emery, in a field survey on July 7, 1999 do hereby state that under requirements of P.A. 74, Michigan P.A. of 1970, the corner points mentioned in lines 1 and 2 above were in conformance with regulations and rules therefore as required in the current manual of survey instructions of the United States Department of the Interior, Bureau of Land Management or by a decree of a Court of Law and for that the corner points mentioned in lines 3, 4 and 5 above were in conformance with the rules of the Michigan Board of Land Surveyors or by a Decree of a Court of Law; established, re-established, monumented, recovered, found as expressed below:

NOTE: Not more than 2 corners, all in the same town and range, may be recorded on this certificate.

τ	i	l	i				T	Ι	\Box			
2	⊢	ė—	ļ ļ	<u>;</u> —	;	ļ	<u> </u>	<u> </u>	 - ;	ģ	<u> </u>	l
3		<u> </u>				_		<u> </u>	_			
4	Ŀ	ļ	L,	9		9 <u> </u>	<u> </u>	0	1	1	1	2
5	_	L-					ļ		_			
6		l 8—	_1	7	1	6—	1	5	1	4	1	3
7			\Box					Ĺ				
8	l	ا_وا	2	0	2	1	2	2	2	3	2	4
9		Ш										
10	3	0	2	ا۔	 2	a_	2	,	2	ا ے	2	
					Ĩ				اً		_[
11			J			_]						
12	3	ŀ	3: t	2	3: I	3—]	—3 I	4-	—3 ¹	5—	3 ⁻	6
- 1			- 1			- 1			. 1	1		

- A. Description of original monument and accessories and/or subsequent restoration:
- GLO; PARKE, D.S.; SET POST; BIRCH 8 N88E 16, CEDAR 8 N73-1/2W 5-1/2. 1835
- GRAVLIN, PS#23510; LCRC P. 21; SET 1/2 IRON BY PROPORTIONATE MEASURE; N50E 21.72' NAIL 18" ASH, S70E 98.48' NAIL 30" POPLAR, S30W 53.32' NAIL 12" BIRCH 1980
- 1980 BECK-GRAVLIN ASSOC.; GRAVLIN, PS#23510; SURVEY L. 509 P. 883 (DUPLICATE IN L. 523 P. 68), ACCESSORIES SAME AS IN 1980 BECK-GRAVLIN SURVEY CITED ABOVE.
- 1022 DUNTON LAND SURVEYING; DUNTON, PS#23503; SURVEY L. 582 P. 967-968; FOUND 1/2" IRON; N30E 21.72' NAIL IN 18" ASH, EAST 24.43' 1/2" ROD @ NE COR. SEC. 2 T13N-R11E, S70E 98.48' NAIL IN 30" POPLAR, S20E 25.5' 1/2" ROD IN CENTER OF ROAD, S30W 53.32' NAIL IN 12" POPLAR
- ROWE ENGINEERING; FIELD, PS #37276; SURVEY L. 662 P. 190-191; FOUND 1/2" ROD, N30E 21.72' NAIL IN 20" ASH, S70E 98.48' NAIL 1993 IN 34" POPLAR, S20E 25.5' 1/2" ROD IN CENTER OF ROAD, EAST 24.43' 1/2" ROD.
- Description of corner evidence found and/or method applied in restoring or reestablishing corner: R
- 1999 EMERY, PS#24593; FOUND 1/2" IRON; FOUND NO PREVIOUS WITNESSES. DISTANCES TO CORNERS H-13 AND J-13 ARE IN GOOD AGREEMENT WITH CA. 1985 GRAVLIN SURVEY AND 1988 DUNTON SURVEY CITED ABOVE.

ACCEPTED FOUND 1/2" IRON AS BEST AVAILABLE EVIDENCE OF ORIGINAL CORNER POSITION.

* CA. 1985 GRAVLIN, PS# 23510; UNRECORDED SURVEY IN SEC. 34; NO MENTION OF OBJECT OR ACCESSSORIES CA. KARIM. CA. 1985 GRAVLIN, PS# 23510; UNRECORDED SURVEY IN SEC. 34; NO MENTION OF OBJECT OR ACCESSSORIES

LOHELA
PROFESSIONAL
SURVEYOR
NO.
44289

THAN RITE

S68°E, 25.63°, FOUND ½° IRON


CAP #23503

S60°E, 98.65'FOUND PK NAIL IN N. FACE OF 40" COTTONWOOD S30°W, 47.30, SET PK NAIL IN NW FACE OF 18" WHITE PINE N50°W,53.64, SET REMON. TAG IN SW FACE OF 16" POPLAR


NORTH, 32.68', FOUND 12" REBAR & CAP #23503

DUE TO THE UNTIMELY ILLNESS OF MR. LIONEL ROY EMERY, I, KARI M. LOHELA, HAVE REVIEWED HIS FIELD NOTES AND PREPARED THIS FORM FOR PEER GROUP REVIEW

Signed by Kill	Date 12/15/99
Surveyor's Michigan License No. 44289	

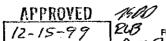

FORM APPROVED BY MICHIGAN STATE BOARD OF PROFESSIONAL SURVEYORS, JAN. 28, 1971 REVISED MAY 14,1975 REVISED JAN., 1993 REVISED OCT., 1995

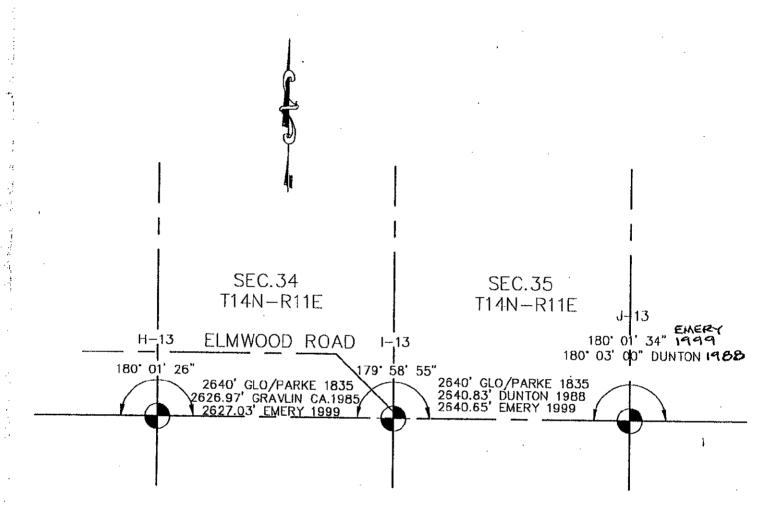

SEC.3 T13N-R11E SEC. 2 T13N-R11E

EXECUTE