

1999 REMONUMENTATION PROGRAM

LAND CORNER RECORDATION CERTIFICATE Filing Requirement of Act 74, Mich. P.A. 1970

LIDER NO. EKAGE NO. #50	
LIDER NO. PAGE NO #5	4
"MENO ELKland Tu	Ż

99	DEC	20	AM	Ω.	22
			#75 #		, ,

For corners in EIkland	Twp.		The yould
Tuscola (County)	Located In:	Corner Code #	TUSCOLA COUNTY RECUSTES OF DEEDS
1. Public Land Survey	T 14NR TR TR	11E J-13	20 S. C.
Property Controlling in Section Miscellaneous Property in Sec.	STR_ STR_ STR_ STR_		Register of Deeds Stamp & File Numb
4. Lot No, Recor	rded Plat		ABCDEFGHIJK:

I Lionel Roy Emery , in a field survey on July 7 , 1999 do hereby state that under requirements of P.A. 74, Michigan P.A. of 1970, the corner points mentioned in lines 1 and 2 above were in conformance with regulations and rules therefore as required in the current manual of survey instructions of the United States Department of the Interior, Bureau of Land Management or by a decree of a Court of Law and /or that the corner points mentioned in lines 3, 4 and 5 above were in conformance with the rules of the Michigan Board of Land Surveyors or by a Decree of a Court of Law; established, re-established, monumented. recovered, found as expressed below:

NOTE: Not more than 2 corners, all in the same town and range, may be recorded on this certificate.

1	<u>A</u> _	R	Ç	<u>ע</u>	E	F'	G	H	Ι	J	Ķ.	Lŀ
1	1			1				Ī		Γ	Т	Γ
2	-	6—	十	5	+	4	+-	3-	 	? —	+-	į
3	-	┼	-	⊢		 _		ـ	—		1—	
4	-	- 7	-	ā.— Į	+	9	<u> </u>	 !0	ļ ₁	 1—	<u> </u> 1	2—
5	-	\vdash		⊢	_		┢	<u> -</u> -	-	L	 	_
6	<u></u> 1	ļ o —	<u> </u> -1	<u>'</u> 7		6	 1	5—	ļ_,	4	<u> </u>	3
7	ļ	<u> </u>	<u> </u>	ļ	$oxed{oxed}$	L	<u> </u>	L	<u>L</u>		<u> </u>	
8	1	ا و_	2	0_	<u> </u>	 1	<u>_</u> 2	2	2	3	2	4
9	ļ .		_	L	ļ	L	<u> </u>	_	_	<u>_</u>	<u> </u>	
10	3		<u>2</u>	9	<u> </u> 2	8—	2	7—	<u> </u> _2	6	2	5—
11		L			\vdash		_	<u> </u>				
12	—3	1	3	2—	3	3	— ₃	4	<u> </u>	5	3	6—
13		L				L	'	<u> </u>		_		

- A. Description of original monument and accessories and/or subsequent restoration:
- 1835 GLO; PARKE, D.S.; SET POST; HEMLOCK 10 N84E 15, BEECH 12 N63-1/2W 25.
- 1988 DUNTON LAND SURVEYING, DUNTON, PS#23503; SURVEY L. 582 P. 967-968; FOUND LARGE STONE & SET 1/2" ROD; EAST 22.38' 1/2" ROD & CAP #11192, S65E 53.0' PK IN N. FACE 15" POPLAR, S30E 43.7" TELEPHONE PED., N50W 41.0' PK IN SW FACE 8" POPLAR
- Description of corner evidence found and/or method applied in restoring or reestablishing corner;
- EMERY, PS#24593; FOUND 1/2" IRON W/CAP AT SW CORNER OF LARGE STONE; FOUND NO PREVIOUS ACCESSORIES. 1999 DISTANCES TO CORNERS I-13 AND K-13 ARE IN GOOD AGREEMENT WITH 1988 DUNTON SURVEY CITED ABOVE.

ACCEPTED FOUND 1/2" IRON AS BEST AVAILABLE EVIDENCE OF ORIGINAL CORNER POSITION.

C. Description of monument for corner and accessories established to perpetuate locating the position of the corner KARI M

J-13

SET STD. REMON. MONUMENT STAMPED 113 TIAN BUS

N65592 CC 21 CC


N65°E, 56.31', SET REMON. TAG IN NW FACE OF 10" POPLAR S30°E, 63.95', SET REMON. TAG IN NE FACE OF 8" POPLAR S15°W, 66.76', SET REMON. TAG IN W. FACE OF 8" PINE N30°W, 40.77', SET REMON. TAG IN NE FACE OF 12" POPLAR



DUE TO THE UNTIMELY ILLNESS OF MR. LIONEL ROY EMERY, I, KARI M. LOHELA, HAVE REVIEWED HIS FIELD NOTES AND PREPARED THIS FORM FOR PEER GROUP REVIEW


Signed by fer M. Ch	Date	12/15/99	
Surveyor's Michigan License No. 44289	•		·

107,770,600,600,607,77

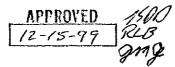

FORM APPROVED BY MICHIGAN STATE BOARD OF PROFESSIONAL SURVEYORS, JAN. 28, 1971

REVISED MAY 14,1975 REVISED JAN., 1983 REVISED OCT., 1995

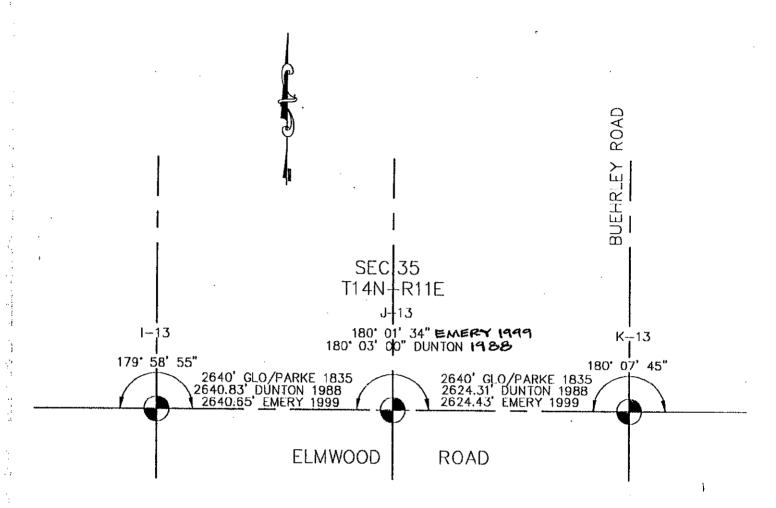

SEC.2 T13N-R11E