

DEC 8 2000

SECTION

1994 REMONUMENTATION PROGRAM  
**LAND CORNER RECORDATION CERTIFICATE**  
 Filing Requirement of Act 74, Mich. P.A. 1970

For corners in ELKLAND TOWNSHIP

RECEIVED FOR RECORD  
 LIBER NO. \_\_\_\_\_ PAGE NO. \_\_\_\_\_  
 FILING NO. # 37  
 ELKLAND Twp.  
 94 NOV -9 PM 2:15  
 VIRGINIA H. McCLAREN  
 TUSCOLA COUNTY  
 REGISTER OF DEEDS

TUSCOLA Located In: Corner Code #  
 (County)

1. Public Land Survey T 14N R 11E M-6  
 T \_\_\_\_\_ R \_\_\_\_\_  
 T \_\_\_\_\_ R \_\_\_\_\_  
 T \_\_\_\_\_ R \_\_\_\_\_

2. Property Controlling S \_\_\_\_\_ T \_\_\_\_\_ R \_\_\_\_\_  
 in Section S \_\_\_\_\_ T \_\_\_\_\_ R \_\_\_\_\_

3. Miscellaneous S \_\_\_\_\_ T \_\_\_\_\_ R \_\_\_\_\_  
 Property in Sec. S \_\_\_\_\_ T \_\_\_\_\_ R \_\_\_\_\_

4. Lot No. \_\_\_\_\_, Recorded Plat \_\_\_\_\_

5. Private Claims \_\_\_\_\_

Register of Deeds Stamp & File Number

I, Lionel Roy Emery, in a field survey on July 28, 1994, do hereby certify that under requirements of P.A. 74, Michigan P.A. of 1970, the corner points mentioned in lines 1 and 2 above were in conformance with regulations and rules therefore as required in the current manual of survey instructions of the United States Department of the Interior, Bureau of Land Management or by a decree of a Court of Law and/or that the corner points mentioned in lines 3, 4 and 5 above were in conformance with the rules of the Michigan Board of Land Surveyors or by a Decree of a Court of Law; established, re-established, monumented, re-monumented, recovered, found as expressed below:


NOTE: Not more than 4 corners, all in the same town and range, may be recorded on this certificate.

	A	B	C	D	E	F	G	H	I	J	K	L	M
2	6		5		4		3		2				
3													
4	7		8		9		10		11		12		
5													
6	18		17		16		15		14		13		
7													
8	19		20		21		22		23		24		
9													
10	30		29		28		27		26		25		
11													
12	31		32		33		34		35		36		
13													

A. Description of original monument and accessories and/or subsequent restoration:  
 1835 (Gov't. Land Office Notes) Harvey Parke, D.S. -Set qr. Sec. post- B. Ash 17 S16½W 51; Elm 15 N30½W 36½  
 1895 (County Surveyor's Record, pages 164 and 165, Sanilac County) M.E. Ward, Surveyor plat shows stake at West ¼ corner of Section 18, T14N-R12E--does not say whether found or set-- no accessories given.

B. Description of corner evidence found and/or method applied in restoring or reestablishing corner:  
 Restored by single proportion measure. Position falls in old barbed-wire fence remains East-West and approximately 6' West of fence line to North only. Also falls in centerline of old roadbed as defined by side ditches.

C. Description of monument for corner and accessories established to perpetuate locating the position of the corner:  
 Set Standard Tuscola County Concrete Monument with 2" Brass Cap stamped M6 T14N/R11E  
 N50°E, 20.44' -T.C. Re-mon. tag, Southeast face 12" Triple Ash.  
 S30°E, 16.42' -T.C. Re-mon. tag, Northeast face 6" Ash.  
 S30°W, 26.82' -T.C. Re-mon. tag, Southeast face 10" Elm.  
 N60°W, 25.18' -T.C. Re-mon. tag, Southwest face 12" Triple Maple.  
 South, 1.0' -"Survey Marker" witness post.

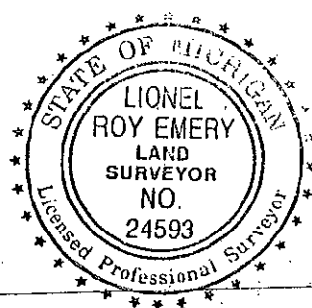

Signed by Lionel Roy Emery Date Oct. 20, 1994

Surveyor's Michigan License No. 24593

APPROVED  
 10-20-94  
 ASD  
 gmq  
 JMT

COPY

