

DEC 07 1994

1994 REMONUMENTATION PROGRAM
LAND CORNER RECORDATION CERTIFICATE
Filing Requirement of Act 74, Mich. P.A. 1970

COMMISSION

For corners in ELKLAND TOWNSHIP

TUSCOLA (County) Located In: Corner Code #/

1. Public Land Survey	T 14N R 11E	M-11
	T R	
	T R	
	T R	
2. Property Controlling in Section	S T R	
	S T R	
3. Miscellaneous Property in Sec.	S T R	
	S T R	

RECEIVED FOR RECORD
LIBER NO. _____ PAGE NO. _____
FILING NO. #42
ELKLAND TOWNSHIP
94 NOV -9 PM 2:16
VIRGINIA M. MOLARONE
TUSCOLA COUNTY
REGISTER OF DEEDS
COPY
Register of Deeds Stamp & File Number

4. Lot No. _____, Recorded Plat _____
5. Private Claims _____

A	B	C	D	E	F	G	H	I	J	K	L
2	6	5	4	3	2						
3											
4	7	8	9	10	11	12					
5											
6	18	17	16	15	14	13					
7											
8	19	20	21	22	23	24					
9											
10	30	29	28	27	26	25					
11											
12	31	32	33	34	35	36					
13											


Lionel Roy Emery in a field survey on July 25, 1994, do hereby certify that under requirements of P.A. 74, Michigan P.A. of 1970, the corner points mentioned in lines 1 and 2 above were in conformance with regulations and rules therefore as required in the current manual of survey instructions of the United States Department of the Interior, Bureau of Land Management or by a decree of a Court of Law and/or that the corner points mentioned in lines 3, 4 and 5 above were in conformance with the rules of the Michigan Board of Land Surveyors or by a Decree of a Court of Law; established, re-established, monumented, re-monumented, recovered, found as expressed below:

NOTE: Not more than 4 corners, all in the same town and range, may be recorded on this certificate.

A. Description of original monument and accessories and/or subsequent restoration:
 1835 (Gov't. Land Office Notes) Harvey Parke, D.S. -set post corner Secs. 25 & 36 Spruce 9 S4W 17½; Pine 12 N70W 24
 1961 (Michigan State Highway M-81 Right of Way Plan) nothing shown at County Line
 1978 (Survey -Liber 492, pages 552 and 553, Tuscola County) Stewart G. Case, P.S. 15399 -Found 3/4"x1½" steel bar in Mon. box in place.- Cor. 6.35 South of Highway Centerline; Spike in SW side of P.P., N45°W, -83.27'; Spike in SE side of P.P., N55°E, -81.5'; NW Cor. of S. Hdwl., S20°E, 28.02'

B. Description of corner evidence found and/or method applied in restoring or reestablishing corner:
 Found steel bar in Monument Box.
 Accepted found iron as marking original corner.

C. Description of monument for corner and accessories established to perpetuate locating the position of the corner:
 Placed 5/8" diameter 9" long reinforcing rod with 2" Brass Cap over iron in Monument Box. Reinforcing rod with Brass Cap placed in concrete, Brass Cap stamped M11 T14N/R11E
 N45°E, 81.53' -T.C. Re-mon. tag above found nail in Southeast face of Power Pole.
 S40°E, 56.58' -T.C. Re-mon. tag in Northeast face of Telephone Pole.
 S62°W, 74.38' -T.C. Re-mon. tag in Southeast face of Power Pole.
 N45°W, 83.13' -T.C. Re-mon. tag above found nail in Southwest face of Power Pole.

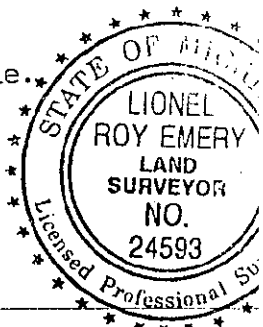

Signed by Lionel Roy Emery Date Oct. 20, 1994
 Surveyor's Michigan License No. 24593

APPROVED
 10-20-94
 ASD
 gmj
 JMT

COPY

