


GOVERNMENT SURVEY CORNER NUMBERING CODE DIAGRAM

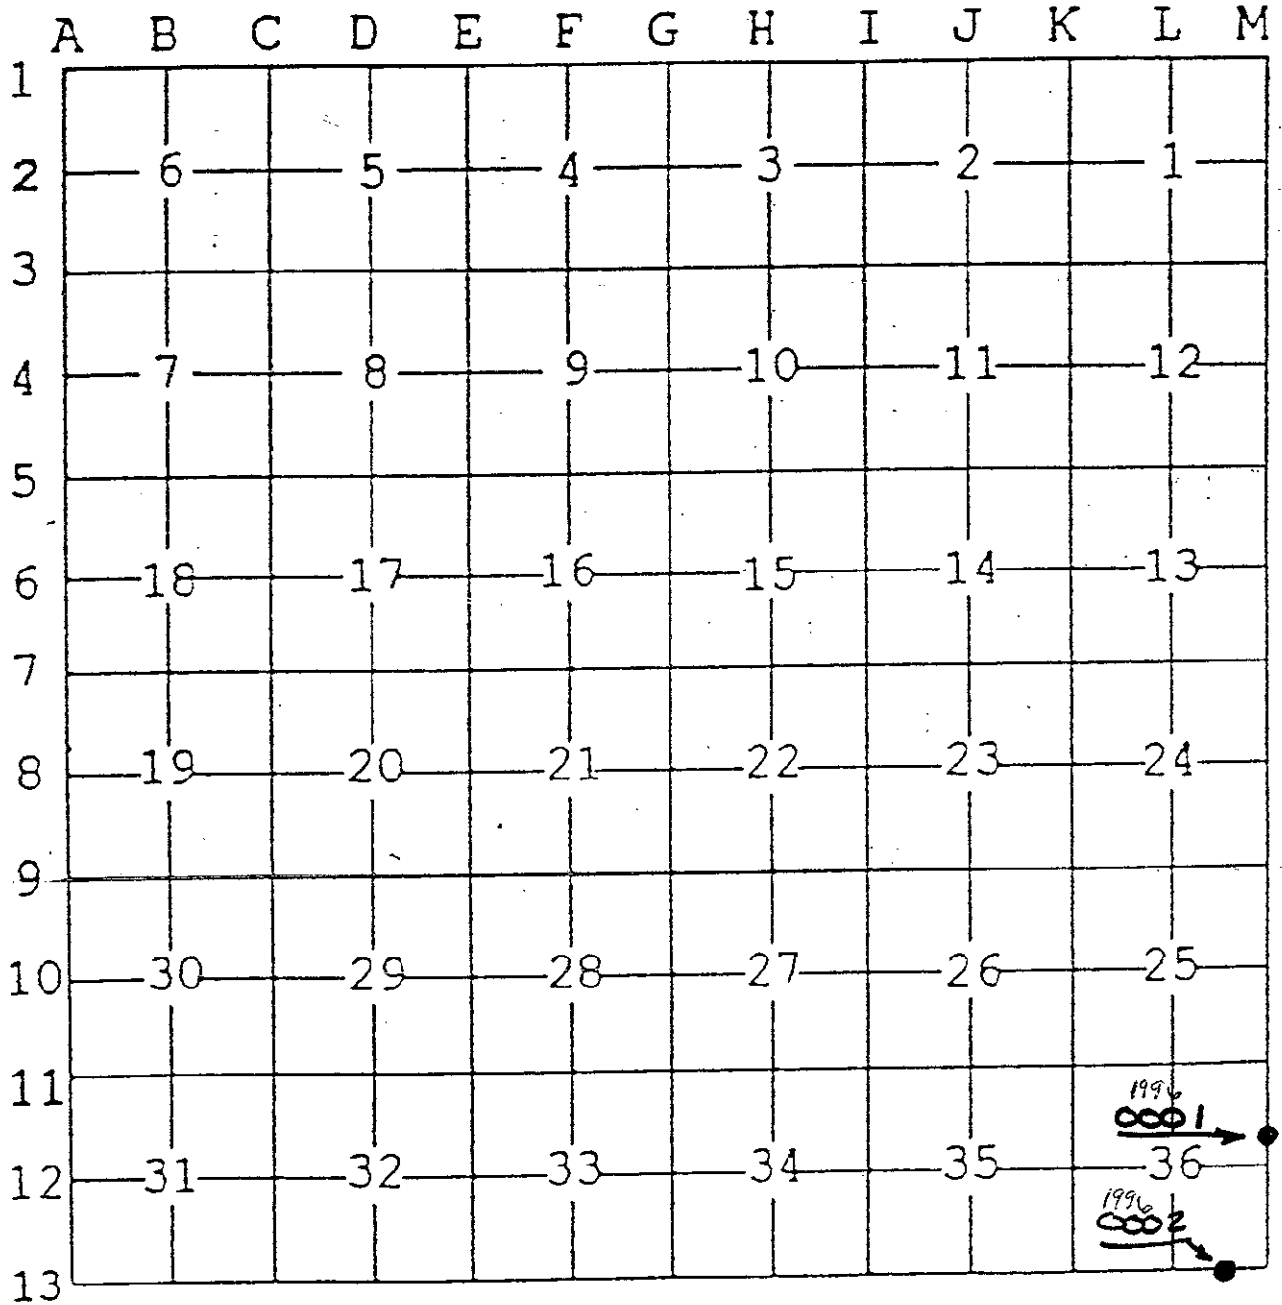

1996
 0001 → ●
 1996
 0002 → ●

SURVEY &
REMONUMENTATION

FEB 28 1997

COMMISSION

NORTH AKRON TWP.

T 15 N - R 7 E