

# LAND CORNER RECORDATION CERTIFICATE

## FILING REQUIREMENT OF ACT 74, MICH. P.A.1970

#4

FOR CORNERS OF--:	LOCATED IN--:	CORNER CODE NUMBER
1. PUBLIC LAND SURVEY <u>29</u> T. <u>15</u> N. R. <u>8</u> E.		D-10
2. PROPERTY CONTROLLING IN SECTION <u>2</u> T. <u>15</u> N. R. <u>8</u> E.		8
3. MISCELLANEOUS PROPERTY IN SECTION _____ T. _____ S. R. _____ W.		
4. LOT NO. _____, RECORDED PLAT _____		
5. PRIVATE CLAIMS _____		

REGISTER OF DEEDS STAMP AND FILING NUMBER

I, Thomas G. Moran, do hereby certify that under requirements of P.A. 74, Michigan P.A. of 1970, the corner points mentioned in lines 1 and 2 above were, in a field survey on September, 1979, established, re-established, monumented, re-monumented, recovered or restored as expressed below and in conformance with regulations and rules therefore as required in the current manual of survey instructions of the United States Department of the Interior, Bureau of Land Management or by a decree of a court of law. Furthermore, that the corner points mentioned in lines 3, 4 and 5 above were, in a field survey on \_\_\_\_\_, 19\_\_\_\_, found, recovered, restored, established or re-established as expressed below and in conformance with the rules of the Michigan State Board of Registration for Land Surveyors or, by a Decree of a Court of law:

A. Description of original monument and accessories and/or subsequent restoration:

B. Description of corner evidence found and/or method applied in restoring or re-establishing corner:

- D-10 Center of Section set by using G. B. Felton survey of 1902. Set 4"x 36" concrete monument with aluminum cap.
- 8 Found pointed cedar post as set by G. B. Felton survey of 1902. Set 4"x 36" concrete monument with aluminum cap.

C. Description of monument for corner and accessories established to perpetuate locating the position of the corner:

- |   |   |
|---|---|
| D-10 4" concrete monument.<br>West 33.00 concrete mon. on R.O.W.<br>West 2.5' Edge of gravel<br>East 5.0' c Gravel Road<br>No other witnesses close to corner | 8 4" concrete monument.<br>N 35° E 16.60' 7" W. Ash<br>N 60° E 48.78' 4" W. Ash<br>S 68° E 21.56' 5" Elm<br>S 40° E 27.48' 3" Cherry (Clump of 3) |
|---|---|


SIGNED BY \_\_\_\_\_ DATE \_\_\_\_\_

SURVEYOR'S MICHIGAN REGISTRATION NO. \_\_\_\_\_ (SEAL)

FOR STATE AND UNITED STATES AGENCIES:

SIGNED BY \_\_\_\_\_ DATE \_\_\_\_\_

APPROVED AND SIGNED BY Thomas G. Moran DATE \_\_\_\_\_  
CHIEF OF SURVEY PARTY  
MICHIGAN REGISTERED LAND SURVEYOR

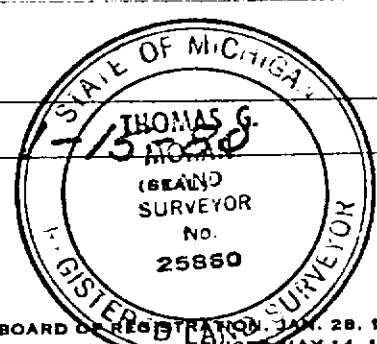

SURVEYOR'S MICHIGAN REGISTRATION NO. 25860