

MAY 05 1997

COMMISSION

1996 REMONUMENTATION PROGRAM  
LAND CORNER RECORDATION CERTIFICATE  
Filing Requirement of Act 74, Mich. P.A. 1970

For corners in N. Akron Twp.

<u>Tuscola</u> (County)	Located In:	Corner Code #
1. Public Land Survey	T15N R 8E	D-13
	T___ R___	_____
	T___ R___	_____
	T___ R___	_____
2. Property Controlling in Section	S___ T___ R___	_____
	S___ T___ R___	_____
3. Miscellaneous Property in Sec.	S___ T___ R___	_____
	S___ T___ R___	_____

4. Lot No. \_\_\_\_\_, Recorded Plat \_\_\_\_\_  
5. Private Claims \_\_\_\_\_

I, Kenneth D. Dunton in a field survey on Aug. 25 1996 do hereby state that under requirements of P.A. 74, Michigan P.A. of 1970, the corner points mentioned in lines 1 and 2 above were in conformance with regulations and rules therefore as required in the current manual of survey instructions of the United States Department of the Interior, Bureau of Land Management or by a decree of a Court of Law and/or that the corner points mentioned in lines 3, 4 and 5 above were in conformance with the rules of the Michigan Board of Land Surveyors or by a Decree of a Court of Law; established, re-established, monumented, recovered, found as expressed below:

NOTE: Not more than 2 corners, all in the same town and range, may be recorded on this certificate.

A. Description of original monument and accessories and/or subsequent restoration:

G.L.O. 1821  
Joseph Wampler, D.S.  
Set 1/2 mile post in mound  
No accessories given.

Dec. 7 & 8, 1869 Survey of Sec. 32, T15N-R8E  
by D. E. Cranston, County Surveyor.  
Post in marsh: Brick & stones. No accessories given.

Note: Section A continued on back of form.

B. Description of corner evidence found and/or method applied in restoring or reestablishing corner:

Found 1/2" rod in mon. box. Held rod in mon. box as the best evidence of the original corner.

C. Description of monument for corner and accessories established to perpetuate locating the position of the corner:


Removed 1/2" rod and encased 5/8" rod & standard brass cap in concrete in mon. box. Stamped cap Corner D-13, T15N-R8E.  
S67°E 24.07' chiseled "+" atop S. end of 40' M.P.P.A.  
N34°E 36.25' chiseled "+" atop N. end of 40' M.P.P.A.  
S62°E 83.15' set T.C. Remon. tag & spike in NE face new P. Pole.  
N40°E 94.5' center 6" tree. / East 22'± centerline Belgian Drain to North.  
N63°E 84.26' set T.C. Remon. tag & spike in NW face P. Pole.  
West 10'± physical centerline gravel road north.  
North 10'± physical centerline E-W asphalt pavement.

Signed by [Signature]  
Surveyor's Michigan License No. 23503

Date 12-7-96

APPROVED  
12-7-96

[Handwritten initials]

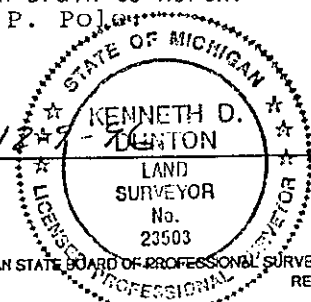

FORM APPROVED BY MICHIGAN STATE BOARD OF PROFESSIONAL SURVEYORS, JAN. 28, 1971  
REVISED MAY 14, 1975  
REVISED JAN., 1983  
REVISED OCT., 1995

RECEIVED FOR RECORD  
LIBER NO. \_\_\_\_\_ PAGE NO. 45  
INDEXED N. AKRON TWP.  
96 DEC 25 PM 3:39  
Register of Deeds Stamp & File Number

	A	B	C	D	E	F	G	H	I	J	K	L	M
1													
2	6			5		4		3		2		1	
3													
4	7			8		9		10		11		12	
5													
6	10			17		16		15		14		13	
7													
8	19			20		21		22		23		24	
9													
10	30			29		28		27		26		25	
11													
12	31			32		33		34		35		36	
13													

July 6, 1922, minutes of survey of the Belgian Drain, Book 29 on Pages 233 & 234 of the County Drain Records. No mention of objects found or set or accessories. The notes indicate that the head of the drain was 0.40 chains (26.4') N. and 0.50 chains (33') E. of SW corner of W 1/2 of SE 1/4 Sec. 32, T15N-R8E.

Oct. 19, 1957 Witness card on file at T.C.R.C. Private survey on 8-10-57 by R. J. Black found metal.

S45°E 82.80' Power Pole & Guy Pole.  
N50°E 84.00' comb. Tele. & Power Pole.

May 20, 1978 Survey by Earl E. Gravlin, RLS #23510, Liber 488-Page 547


N45°E 84.13' nail in Power Pole.  
S60°E 83.20' nail in Power Pole.  
East 22.00' 60" C.M.P.

North 10.50' centerline Bay Park Rd. Set 1/2" iron.

April 23, 1979 Survey by Earl E. Gravlin, RLS #23510, Liber 496-Page 1491.

Found 1/2" iron. Accessories same as L-488, P-547.

Sec. 32, T15N-R8E

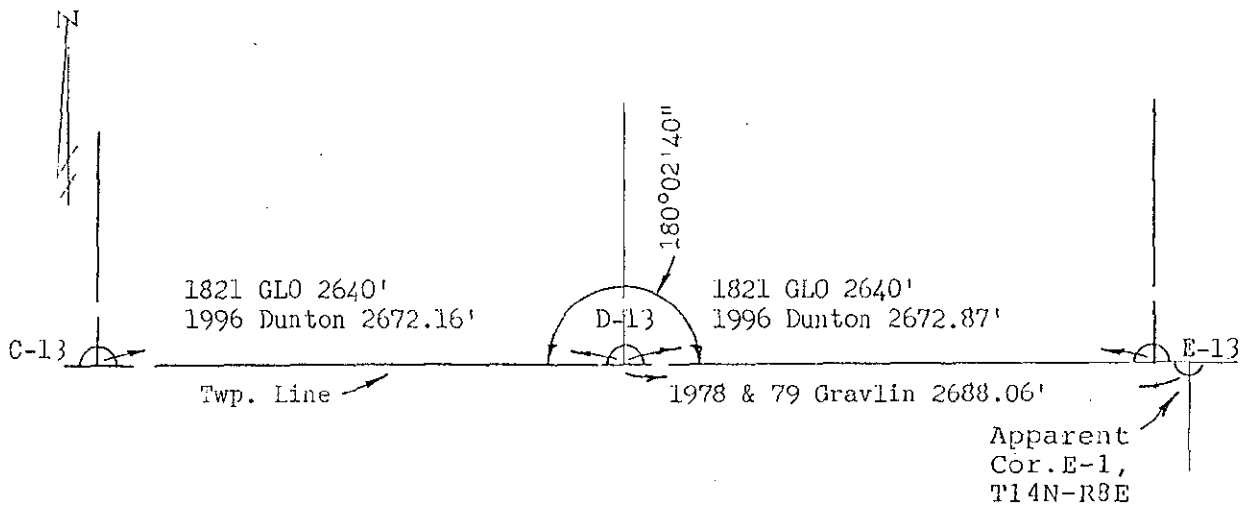

Sec. 5, T14N-R8E