

SURVEY &
REMONUMENTATION

MAY 05 1997

COMMISSION

1996 REMONUMENTATION PROGRAM
LAND CORNER RECORDATION CERTIFICATE
Filing Requirement of Act 74, Mich. P.A. 1970

For corners in N. Akron Twp.

<u>Tuscola</u> (County)	Located in:	Corner Code #
1. Public Land Survey	<u>T15NR 8E</u>	<u>F-13</u>
	T <u> </u> R <u> </u>	<u> </u>
	T <u> </u> R <u> </u>	<u> </u>
	T <u> </u> R <u> </u>	<u> </u>
2. Property Controlling in Section	S <u> </u> T <u> </u> R <u> </u>	<u> </u>
	S <u> </u> T <u> </u> R <u> </u>	<u> </u>
3. Miscellaneous Property in Sec.	S <u> </u> T <u> </u> R <u> </u>	<u> </u>
	S <u> </u> T <u> </u> R <u> </u>	<u> </u>

4. Lot No. _____, Recorded Plat _____
5. Private Claims _____

I, Kenneth D. Dunton, in a field survey on June 30, 1996 do hereby state that under requirements of P.A. 74, Michigan P.A. of 1970, the corner points mentioned in lines 1 and 2 above were in conformance with regulations and rules therefore as required in the current manual of survey instructions of the United States Department of the Interior, Bureau of Land Management or by a decree of a Court of Law and /or that the corner points mentioned in lines 3, 4 and 5 above were in conformance with the rules of the Michigan Board of Land Surveyors or by a Decree of a Court of Law; established, re-established, monumented, recovered, found as expressed below:

NOTE: Not more than 2 corners, all in the same town and range, may be recorded on this certificate.

A. Description of original monument and accessories and/or subsequent restoration:

G.L.O. 1821	Dec. 26 to 31, 1901
Joseph Wampler, D.S.	Survey of Section 33, T15N-R8E by
Set post for 1/4 sec.	G. B. Felton, County Surveyor
cor. in mound.	Set from measure, 2" gas pipe at
No accessories.	corner. No accessories given.

Note: Section A continued on back of form.

B. Description of corner evidence found and/or method applied in restoring or reestablishing corner:


Found nothing. Re-established corner proportional to 1901 resurvey of Section 33 by G. B. Felton.

C. Description of monument for corner and accessories established to perpetuate locating the position of the corner:

Placed standard monument stamped Corner F-13, T15N-R8E.
Placed monument box over monument.
S25°E 20.90' chiseled notch atop S. end of 50' M.P.P.A.
N14°E 32.35' chiseled notch atop N. end of 50' M.P.P.A.
S72°W 76.38' set T.C. Remon. tag & spike in NW face P. Pole.
N41°W 109.73' set T.C. Remon. tag & spike in NE face P. Pole.
N10°W 82.00' set T.C. Remon. tag & spike in E. face P. Pole.
North 9'± physical centerline E-W asphalt pavement.
S73°11'W 13.14' fnd. 1/2" rod in mon. box. Apparent Cor. REF OF MICHIGAN R8E.
East 4'± centerline of Cook Drain to North (not centerline of pipe as sh)

Signed by [Signature] Date 12-9-96
Surveyor's Michigan License No. 23503

APPROVED
12-9-96
[Signatures]

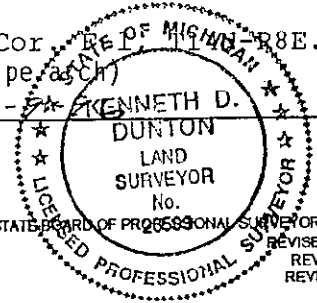


FORM APPROVED BY MICHIGAN STATE BOARD OF PROFESSIONAL SURVEYORS, JAN. 28, 1971
REVISED MAY 14, 1975
REVISED JAN., 1983
REVISED OCT., 1995

RECEIVED FOR RECORD
LIBER NO. _____ PAGE NO. 47
INDEXED AT AKRON TWP.
96 DEC 26 PM 3:39
REGISTER OF DEEDS
COUNTY OF TUSCOLA

Register of Deeds Stamp & File Number

	A	B	C	D	E	F	G	H	I	J	K	L	M
1													
2	6		5		4		3		2		1		
3													
4	7		8		9		10		11		12		
5													
6	18		17		16		15		14		13		
7													
8	19		20		21		22		23		24		
9													
10	30		29		28		27		26		25		
11													
12	31		32		33		34		35		36		
13													

April 10, 1928 Minutes of survey of the Cook Drain by Warren Leonard, County Surveyor. Book 31 on Pages 513 through 515 of the County Drain Records. No mention of objects found or set or accessories. The notes indicate that the drain is on the line between the E 1/2 of the SW 1/4 and the W 1/2 of the SE 1/4 said Sec. 33 and enters the NW 1/4 of NE 1/4 Sec. 4, T14N-R8E, 1.12 rods (18.48') East of N 1/4 cor. Sec. 4.

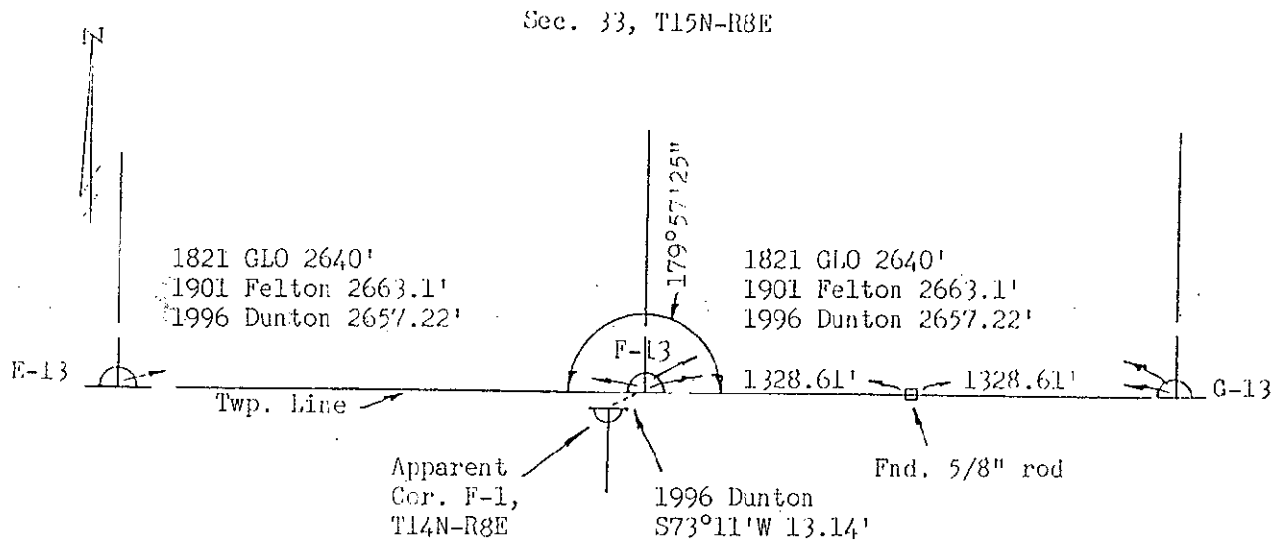

Sec. 4, T14N-R8E