

**SURVEY &  
REMONUMENTATION**

MAY 05 1997

**COMMISSION**

1996 REMONUMENTATION PROGRAM  
LAND CORNER RECORDATION CERTIFICATE  
Filing Requirement of Act 74, Mich. P.A. 1970

For corners in N. Akron Twp.

<u>Tuscola</u> (County)	Located in:	Corner Code #
1. Public Land Survey	T <u>15</u> N <u>R</u> 8 E	<u>J-13</u>
	T <u>   </u> R <u>   </u>	<u>   </u>
	T <u>   </u> R <u>   </u>	<u>   </u>
	T <u>   </u> R <u>   </u>	<u>   </u>
2. Property Controlling in Section	S <u>   </u> T <u>   </u> R <u>   </u>	<u>   </u>
	S <u>   </u> T <u>   </u> R <u>   </u>	<u>   </u>
3. Miscellaneous Property in Sec.	S <u>   </u> T <u>   </u> R <u>   </u>	<u>   </u>
	S <u>   </u> T <u>   </u> R <u>   </u>	<u>   </u>

4. Lot No. \_\_\_\_\_, Recorded Plat \_\_\_\_\_  
5. Private Claims \_\_\_\_\_

I, Kenneth D. Dunton in a field survey on June 30, 1996 do hereby state that under requirements of P.A. 74, Michigan P.A. of 1970, the corner points mentioned in lines 1 and 2 above were in conformance with regulations and rules therefore as required in the current manual of survey instructions of the United States Department of the Interior, Bureau of Land Management or by a decree of a Court of Law and for that the corner points mentioned in lines 3, 4 and 5 above were in conformance with the rules of the Michigan Board of Land Surveyors or by a Decree of a Court of Law, established, re-established, monumented, recovered, found as expressed below:

NOTE: Not more than 2 corners, all in the same town and range, may be recorded on this certificate.

A. Description of original monument and accessories and/or subsequent restoration:

G.L.O. 1821  
Joseph Wampler, D.S.  
Set quarter Section post.  
Cedar 5 N 81 W 2 1/2  
Ash 8 S 10 E 6

Mar. 3, 1973 Survey by Robert G. Kay, RLS #14096,  
Liber 2- Page 332A.  
No mention of object fnd. or set.  
N03°E 45.6' metal stake.  
N50°W 105.6' P.P.  
S45°E 67.8' T.P.

B. Description of corner evidence found and/or method applied in restoring or reestablishing corner:

Found nothing. Re-established from property irons and one accessory found from 1973 Kay Engineering survey.


C. Description of monument for corner and accessories established to perpetuate locating the position of the corner:

Set 5/8" rod and standard brass cap stamped Corner J-13, T15N-R8E. Placed monument box over rod & cap.  
N01°E 45.67' fnd. old steel fence post.  
N03°E 17.79' set 1/2" x 18" rod in road shoulder.  
N47°E 25.96' set 1/2" x 18" rod in road shoulder.  
N44°W 24.67' set 1/2" x 18" rod in road shoulder.  
N60°W 104.40' set T. C. Remon. tag & spike in NE face new P. Pole.

Signed by [Signature]  
Surveyor's Michigan License No. 23503

Date 12-9-96

APPROVED  
12-9-96  
[Signatures]

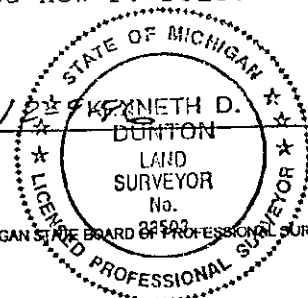


FORM APPROVED BY MICHIGAN STATE BOARD OF PROFESSIONAL SURVEYORS, JAN. 28, 1971  
REVISED MAY 14, 1975  
REVISED JAN., 1983  
REVISED OCT., 1995

Register of Deeds Stamp & File Number

A	B	C	D	E	F	G	H	I	J	K	L	M
1												
2	6		5		4		3		2			
3												
4	7		8		9		10		11		12	
5												
6	18		17		16		15		14		13	
7												
8	19		20		21		22		23		24	
9												
10	30		29		28		27		26		25	
11												
12	31		32		33		34		35		36	
13												

RECORDED FOR RECORD  
LIBER NO. \_\_\_\_\_ PAGE NO. 31  
FILE NO. N. Akron Twp.  
96 DEC 26 PM 3:39  
[Signature]  
TUSCOLA COUNTY  
REGISTER OF DEEDS

Sec. 35, T15N-R8E

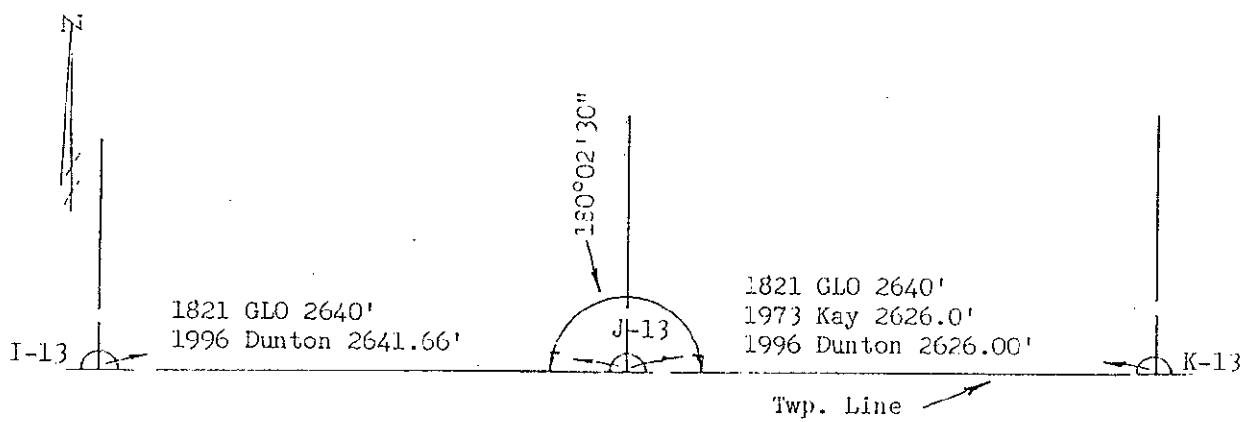

Sec. 2, T14N-R8E