
MAY 0.5 1997

COMMISSION 1996 REMONUNENTATION PROGRAM

LAND CORNER RECORDATION CERTIFICATE
Filing Requirement of Act 74, Mich. P.A. 1970
i

For corners in N. Akron	Twp.	•	1	19. 19.		R NO.)
Tuscola (County)	Located In:	Corner Code #			EC 26		1
1. Public Land Survey	T15NR8E TR TR	K-13	-			PAGE 110.) ; ; ! }
Property Controlling in Section Miscellaneous Property in Sec.	S T R S T R S T R		-		ص ر _د	500	
			·	Register of	f Deeds Stamp	S File Num	ber
4. Lot No, Record 5. Private Claims	ed Plat	·		1 A B C D	EFGI	IJK	L M
				2 - 6 5	, — 4 — — :	3 2	- i
Kenneth D. Dunton requirements of P.A. 74, Michigan conformance with regulations and refunited States Department of the intitude of the corner points mentioned in Board of Land Surveyors or by a recovered, found as expressed belo	P.A. of 1970, the corner point rules therefore as required in the terior, Bureau of Land Manage In lines 3, 4 and 5 above were la Decree of a Court of Law	nts mentioned in lines 1 ne current manual of sun ement or by a decree of a In conformance with the	and 2 above were in vey instructions of the a Court of Law and for rules of the Michigan	6 -18 -17	7161	514	-12-
NOTE: Not more than 2 come on this certificate.	rs, all in the same town and	I range, may be record	led	9 10 30 29	9 28 2	726	
				11 12 31 32	2 33 3	4 35	-36-
A. Description of original mon-				13			_L
G.L.O. 1821 Joseph Wampler, E Set post corner Lynn N 61 1/2 E Beech S 50W .12	Secs. 35 & 36	N45°W 107. N40°W 52.7	Robert G. H	on of obje er house. gn.	#14096, ect fnd.	Liber 2 or set	
B. Description of corner evide	ence found and/or method	l applied in restoring o	or reestablishing corr	ner:			
Found 1 1/4" ir of the original		ument box.	Held iron a	as the be	st evide	nce	
-	` .		·			:	
C. Description of monument fo							,
Set 5/8" rod & s & rod in concret N24°E 44.05' SW N38°E 50.13' SE S36°E 51.41' NE S23°E 45.57' NW East 24'± centerl	te in mon. box corner of Nor- corner of Sou- corner of Sou-	. Stamped of the conc. heath conc. heath conc. heath conc. heath conc. heath	cap, Corner adwall. adwall. adwall. adwall. adwall.	ine of Rox	Culvert.		
	GNII	<	Date /2	in /k	E OF MICHIO	*.	
Signed by 72 Signed by Surveyor's Michigan License No	o. 23503			- 	DUNTON LAND	- 	
Sarreyor S Millerigan License IV	APPROVED	Lh.E.	LM APPROVED BY MICHIGA	AN STATE DA SO	SURVEYOR No. 23503	Spors ian	28 1071
	12-7-96	117n4.	IN APPROVED BY MICHIGA	AN SINIE DONNEROL	OFESSIONAL .	REVISED MAY REVISED JA REVISED OC	14,1975 N., 1983 T., 1995

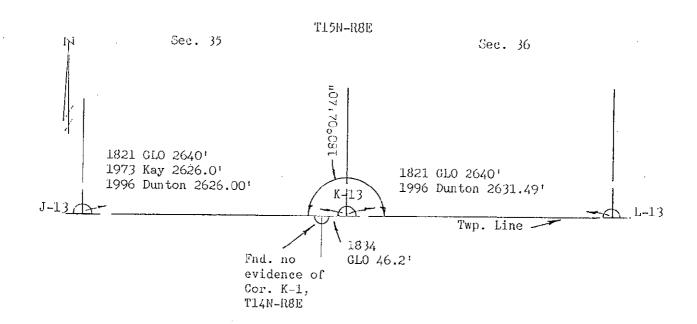

Sec. 2

Sec. 1

T14N-R8E