

**SURVEY &
REMONUMENTATION**

MAY 15 1987

COMMISSION

1996 REMONUMENTATION PROGRAM
LAND CORNER RECORDATION CERTIFICATE
Filing Requirement of Act 74, Mich. P.A. 1970

For corners in N. Akron Twp.

<u>Tuscola</u> (County)	Located In:	Corner Code #
1. Public Land Survey	T <u>15NR</u> R <u>8E</u>	<u>L-13</u>
	T _____ R _____	_____
	T _____ R _____	_____
2. Property Controlling in Section	S _____ T _____ R _____	_____
	S _____ T _____ R _____	_____
3. Miscellaneous Property in Sec.	S _____ T _____ R _____	_____

RECEIVED FOR RECORD
LIBER NO. _____ PAGE NO. 53
FILE NO. N. AKRON TWP.
95 DEC 26 PM 3:40
TUSCOLA COUNTY
REGISTERED SURVEYORS

Register of Deeds Stamp & File Number

4. Lot No. _____, Recorded Plat _____
5. Private Claims _____

A	B	C	D	E	F	G	H	I	J	K	L	M
1												
2	6		5		4		3		2		1	
3												
4	7		8		9		10		11		12	
5												
6	18		17		16		15		14		13	
7												
8	19		20		21		22		23		24	
9												
10	30		29		28		27		26		25	
11												
12	31		32		33		34		35		36	
13												

I, Kenneth D. Dunton in a field survey on June 29, 1996 do hereby state that under requirements of P.A. 74, Michigan P.A. of 1970, the corner points mentioned in lines 1 and 2 above were in conformance with regulations and rules therefore as required in the current manual of survey instructions of the United States Department of the Interior, Bureau of Land Management or by a decree of a Court of Law and for that the corner points mentioned in lines 3, 4 and 5 above were in conformance with the rules of the Michigan Board of Land Surveyors or by a Decree of a Court of Law; established, re-established, monumented, recovered, found as expressed below:

NOTE: Not more than 2 corners, all in the same town and range, may be recorded on this certificate.

A. Description of original monument and accessories and/or subsequent restoration:

G.L.O. 1821 Joseph Wampler, D.S. Set 1/2 mile post Sugar 5 N 75 E 9 Sugar 8 S 68 1/2 W 9	Feb. 12, 1876, H. C. Marvin's Plat of Unionville surveyed and laid out by Roswell Surine, Surveyor. Liber 1 of Plats Page 48, now 49A. The plat does not indicate the location or accessories to corner L-13, T15N-R8E.
--	--

Note: Section A continued on back of form.

B. Description of corner evidence found and/or method applied in restoring or reestablishing corner:

Found 1/2" rod in monument box. Held rod as the best evidence of the original corner.


C. Description of monument for corner and accessories established to perpetuate locating the position of the corner:

Set 5/8" rod and standard brass cap over 1/2" rod in monument box. Encased rod & cap in concrete in mon. box. Stamped cap, Corner L-13, T15N-R8E.
N75°E 78.92' chiseled "+" in S. face of railroad signal post.
S51°E 37.40' chiseled "+" in N. face of railroad signal post.
N45°W 72.50' fnd. M.DOT tag & spike in NE face P. Pole.
N16°W 20.88' chiseled "+" atop center of Bell Sys. M. H. cover.
West 20.28' fnd. 1 1/2" pipe in mon. box. Apparent cor. L-13, T15N-R8E.

Signed by *Kenneth D. Dunton*
Surveyor's Michigan License No. 23503

Date 12-9-96

APPROVED
12-9-96
J.P.C.
ORLB

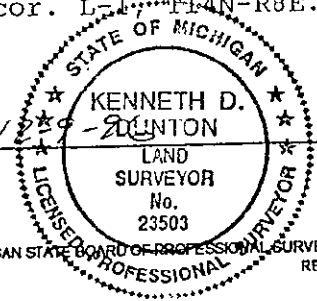

Aug. 30, 1973 Survey by Lloyd D. McGinnis, RLS #18999, Liber 448-Pages 452 & 453.
 No mention of object found or set or accessories.

May 17, 1979 Survey by Russell L. Brown, RLS #24588, Liber 500, Pages 156 & 157.
 Mon. Box.

N50°W 72.96' to spike in P.P.
 N75°E 78.80' cen. R.R. crossing sign.
 S55°E 37.40' cen. R.R. crossing sign.

June 5, 1974 Survey by Russell L. Brown, RLS #24588, Liber 502, Page 756.
 Same object and accessories as L-500, P-156 & 157.

May 26, 1984 Survey by Lloyd D. McGinnis, RLS #18999, Liber 596-Page 760.
 Fnd. mon. box. No accessories given.

Mar. 19, 1991 Survey by Russell L. Brown, L.S. #24588, Liber 611-Pages 396 & 397.
 Same object and accessories as L-502, P-756.

