

1993

1993 REMONUMENTATION PROGRAM

COMMISSION

LAND CORNER RECORDATION CERTIFICATE

Filing Requirement of Act 74, Mich. P.A. 1970
N. AKRON TOWNSHIP

For corners in

TUSCOLA
(County)

Located In:

Corner Code --#

- 1. Public Land Survey T 15N R 8E M-3
- T R _____
- T R _____
- T R _____
- T R _____
- 2. Property Controlling S T R _____
- in Section S T R _____
- 3. Miscellaneous S T R _____
- Property in Sec. S T R _____

- 4. Lot No. _____, Recorded Plat _____
- 5. Private Claims _____

RECEIVED FOR RECORD
 LIBER NO. _____ PAGE NO. 24
 FILING NO. N. Akron
 93 DEC 19 PM 12:01
 VIRGINIA H. HANCOCK
 TUSCOLA COUNTY
 REGISTER OF DEEDS
 Register of Deeds Stamp & File Number

I, Kenneth D. Dunton, in a field survey on Nov. 7, 19 93, do hereby certify that under requirements of P.A. 74, Michigan P.A. of 1970, the corner points mentioned in lines 1 and 2 above were in conformance with regulations and rules therefore as required in the current manual of survey instructions of the United States Department of the Interior, Bureau of Land Management or by a decree of a Court of Law and/or that the corner points mentioned in lines 3, 4 and 5 above were in conformance with the rules of the Michigan Board of Land Surveyors or by a Decree of a Court of Law; established, re-established, monumented, re-monumented, recovered, found as expressed below:

	A	B	C	D	E	F	G	H	I	J	K	L	M
2	6	5	4	3	2	1							
3													
4	7	8	9	10	11	12							
5													
6	18	17	16	15	14	13							
7													
8	19	20	21	22	23	24							
9													
10	30	29	28	27	26	25							
11													
12	31	32	33	34	35	36							
13													

NOTE: Not more than 4 corners, all in the same town and range, may be recorded on this certificate.

A. Description of original monument and accessories and/or subsequent restoration:

1821 G.L.O. Notes No record of subsequent restoration.
 Joseph Wampler, D.S.
 Set post cor. Sec. 1 & 12
 Double W.O. 40" S49°W 1.39 (91.74')
 W.O. 18" N56°W 1.51 (99.66')

B. Description of corner evidence found and/or method applied in restoring or reestablishing corner:

Found 3/4" pipe, stones & 3" cedar post 1.3' north of pipe.
 Accepted evidence as found.

COPY


C. Description of monument for corner and accessories established to perpetuate locating the position of the corner:

Removed 3/4" x 30" pipe & placed standard concrete monument stamped corner M-3, T15N-R8E.
 Set carsonite fiber witness post 1' west. Placed 12" stone @ N. face of mon. & radiated 6 bricks around E. W. & S. sides.
 S01°45'50"W 33.02' found State of Michigan brass tablet - 3" diam. stamped T15N-R9E, 6-2-59, brick & conc. block around tablet.
 S02°48'W 43' N. edge of dredge cut.
 N59°18'W 8.33' set T.C. Re-mon. tag & spike in S. face of 5" trunk of clump 12'+ willow.
 N01°46'W 77.86' set T.C. Re-mon. tag & spike in E. face of 6" ash.
 N01°46'E 32.98' set 3/4" x 18" pipe & cap #23503.
 S88°14'E 17.98' set 3/4" x 18" pipe & cap #23503.
 N02°48'20"E 1040.00' set standard conc. mon. @ Saginaw Bay.

Signed by [Signature] Date Dec. 6, 1993

Surveyor's Michigan License No. 23503

APPROVED
12-8-93

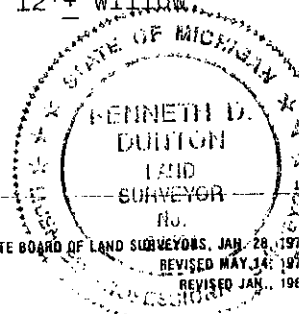

COPY

