Located In:

## COMMISSION


For corners in TUSCOLA

## LAND CORNER RECORDATION CERTIFICATE

Filing Requirement of Act 74, Mich. P.A. 1970
N. AKRON TOWNSHIP

Corner Code =##

(Caunty)	### H H H H H
1. Public Land Survey T 15N R 8E M-8	
TR	
T R	Fa E
2. Property Controlling S T R	ACCORD PARCE 1039 PARCE 1039
in Section S T R	
3. Miscellaneous S T R	Register of Deeds Stamp & File Number
Troperty in dec.	
4. Lot No, Recorded Plat	A B C D E F G H L J K L I
5. Private Claims	
Vousette D. Domber	4 7 8 9 10 11 12
Kenneth D. Dunton in a field survey on Nov. 13 93 do hereby certify that under requirements of P.A. 74, Michigan P.A. of 1970, the corner points mentic	5
in lines 1 and 2 above were in conformance with regulations and rules therefore as required in	1 ine
current manual of survey instructions of the United States Department of the Interior, Bureau of Management or by a decree of a Court of Law and/or that the corner points mentioned in lines 3, 4 a	and 5 8 3 3 3 3 3 3 3 3 3 3 3 3 3 3 3 3 3 3
above were in conformance with the rules of the Michigan Board of Land Surveyors or by a Decree Court of Law; established, re-established, monumented, re-monumented, recovered, found	e of a
expressed below:	10 30 29 28 27 26 25
NOTE: Not more than 4 corners, all in the same town and range, may be recorded	11
on this certificate.	12 31 32 33 34 35 36
A. Description of original monument and accessories and/or subsequent restoration:	13
	of subsequent restoration.
Joseph Wampler, D.S.	or subsequent restoration.
Set 1/2 mi. Post in Pr. (prairie?)	
Pine 11" S 1 1/4°E 8.60 (567.6') No other	
B. Description of corner evidence found and/or method applied in restoring or reesta	blishing corner
Found nothing from excavation. Set 1/2" rod & cap #23503 h	
and at split of measured mile between corners M-7 & M-9, Ti	
	·
	b
•	
Note: See sketch on back of form.	
ì	
C. Description of monument for corner and accessories established to perpetuate local	ating the position of the corner:
Removed rod & cap and placed standard concrete monument wit	
M-8, T15N-R8E. Placed stones around monument.	m a brade cap bramped corner
SO8°53'W 25.35' set T.C. Re-mon. tag & spike in E. face 2	
S14°57'W 46.08' found "+" atop pointed rock on NE ditch to S67°30'W 63.75' set T.C. Re-mon. tag & spike in N. face 6	
NO6°41'E 44.14' set T.C. Re-mon. tag & spike in E. face 9	
West 1'+ set carsonite fiber witness post.	gages of the control
East 2'+ found remains N-S fence buried in topsoil. South 55'+ & East 15'+ centerline of drain west & south.	see the OF MICE
	1, 6
1 Alas	* KENNETH D.\A\\ DUNTON \A\\
	Dec. 6, 1993 * (AND)
Surveyor's Michigan License No23503	SURVEYOR  FORM APPROVED BY MICHIGAN STATE BY AND OF LAND SUPVEYORS, JAN 28, 1971
APPROVED 15110	23 HEVISED MAY 14, 1975
12-6-93	ARVISED JAN., 1983
Jamt.	Application of the contraction o

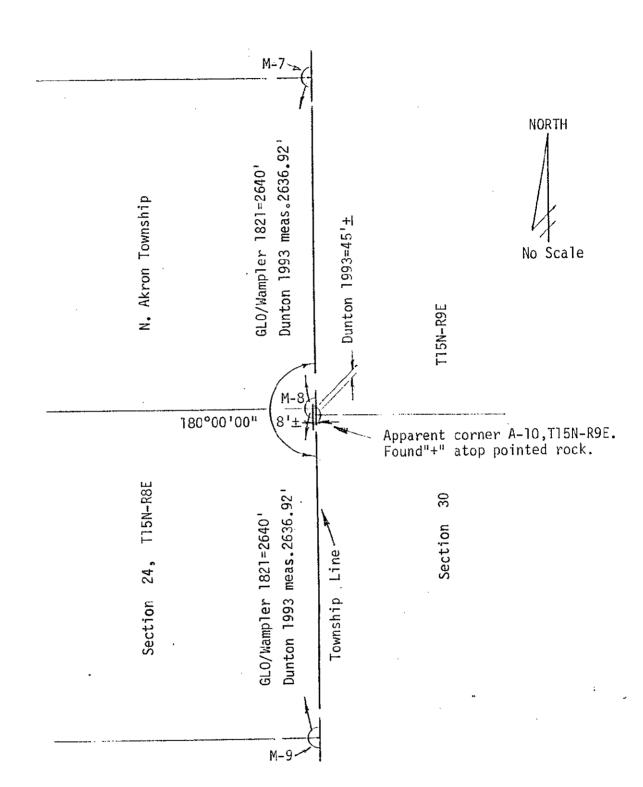

## CODA