

1933

VAN BUREN COUNTY REMONUMENTATION PROGRAM

AUG 20 3 27 PM '93

COMMISSION

LAND CORNER RECORDATION CERTIFICATE
Filing Requirement of Act 74, Mich. P.A. 1970

For corners in

Mark A. Smith
VAN BUREN CO.
REGISTER OF DEEDS

LIBER 4 PAGE 32

VAN BUREN (County)	Located In:	Corner Code #
	Pine Grove Twp.	
1. Public Land Survey	Sec. 19 T1 S. R 13 W.	A-9
	T _____ R _____	
	T _____ R _____	
	T _____ R _____	
2. Property Controlling in Section	S _____ T _____ R _____	
	S _____ T _____ R _____	
3. Miscellaneous Property in Sec.	S _____ T _____ R _____	
	S _____ T _____ R _____	
4. Lot No. _____, Recorded Plat _____		
5. Private Claims _____		

Register of Deeds Stamp & File Number

I, John C. Hunt, P.S. a field survey on Aug. 13 19 93
do hereby certify that under requirements of P.A. 74, Michigan P.A. of 1970, the corner points mentioned in lines 1 and 2 above were in conformance with regulations and rules therefore as required in the current manual of survey instructions of the United States Department of the Interior, Bureau of Land Management or by a decree of a Court of Law and/or that the corner points mentioned in lines 3, 4 and 5 above were in conformance with the rules of the Michigan Board of Land Surveyors or by a Decree of a Court of Law; established, re-established, monumented, re-monumented, recovered, found as expressed below:

NOTE: Not more than 4 corners, all in the same town and range, may be recorded on this certificate.

	A	B	C	D	E	F	G	H	I	J	K	L	M
2	6	5	4	3	2								
3													
4	7	8	9	10	11	12							
5													
6	16	17	16	15	14	13							
7													
8	19	20	21	22	23	24							
9													
10	30	29	28	27	26	25							
11													
12	31	32	33	34	35	36							
13													

A. Description of original monument and accessories and/or subsequent restoration:

4/1830 GLO Robt. Clark, Jr. DS: Ran W. 67.05 ch (4425.30') intersected Town Line 18 lks. (11.88') N. of Post. Set Post at intersection for Sec. 19 & 30. 1865 C.J. Monroe CS: Set stake & 3 stones at all corners. Ran E. 1782.0'; meas. S. 1318.02' to 1/8 Post, cont. S. 1318.02' to 1/4 Post, cont. S. 1318.02' to 1/8 Post & cont. S. 1318.02' to Sec. Cor. Measured N. 2635.38' to 1/4 Post, cont. N. 2635.38' to Sec. Cor. 3/18/1872 Add. of Gobles Add. to the Vill. of Gobleville. 9/3/1894 Killefer's Add. to Vill. of Gobleville. 10/19/1917 McNames' Add. to the Vill. of Gobleville. 12/1924 T.A. Smith CS: On a note for Sec. 19 of Pine Grove, shows job to be 15.4'; angle N. to E. = 89°55'; Wit.: Cor. of Garage NE 52.2', Sidewalk Cor. "C" SE = 40.4'; 2/8/1939 Survey shows corner; 10/17/1945 Survey shows corners; Angle N. to E. = 89°47'30"; 1924/1943 T.A. Smith says Mon Box misplaced by MSHD. Corner 1.1' N. of box. (Cont. B. Description of corner evidence found and/or method applied in restoring or reestablishing corner: on back.)


A-9 Found iron bolt in mon box in C/L road North, South, & East and 15.4' North of C/L of road to West. South 15.4' Harrison Marker in mon box, for SE corner Sec. 24 (M-9) Bloomingdale Twp., T1S-R14W. Removed iron bolt from mon box & replaced it with Harrison Marker.

THIS GOVERNMENT MONUMENT WAS RESTORED WITH APPROVAL OF THE VAN BUREN COUNTY REMONUMENTATION PEER GROUP OF SURVEYORS AT A MEETING HELD ON JULY 28, 1993, AND IS ACCEPTED AS A CAREFUL AND FAITHFUL PERPETUATION OF THE POSITION OF THE ORIGINAL CORNER.

C. Description of monument for corner and accessories established to perpetuate locating the position of the corner:

A-9 HARRISON MARKER IN MONUMENT BOX

South 15.4' Harrison Marker in mon box for M-9 T1S-R14W.
 N.55°W. 32.54' Set nail & tag in SW face pole.
 N.25°E. 51.10' MSHD nail & tag in NW face pole.
 N.80°E. 61.55' MSHD nail & tag in North face pole.
 S.35°W. 55.83' C/L Fire Hydrant.

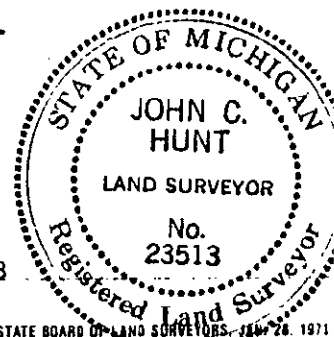

Signed by John C. Hunt, P.S.
 Surveyor's Michigan License No. 23513

Date August 16, 1993

("A" Continued from front.)

10/10/1955 W.Q. Smith CS: 10/21/1955 Survey shows corners. 3/22/1956 Survey shows jog distance bet. mon boxes as 13.9' + 1.1' North. Angle N. to E. = 89°47'30". 4/10/1957 Sec. 24 of Bloomingdale, survey shows corner. 7/28/1960 Sec. 30 of Pine Grove, survey shows distance bet. mon boxes as 10.78' + 1.1' N. for jog marked wrong by self in 1970. Angle S. to E. = 90°12'30". 9/9/1966 D.R. Gilchrist survey in Sec. 24 of Bloomingdale, angle W. to N. = 89°04'30". 1970+ Survey in Sec. 30 of Pine Grove shows corners. Measured E. to ¼ post 1783.35', measured S. to ¼ post 2639.26'. 7/6/1970 D.R. Gilchrist, RLS: Field note shows mon box no good. Set RR spike at 15.4' per T.A. Smith notes North of Bloomingdale corner. 10/11/1971 Survey shows corner (L.1 p.226). 10/13/1971 Corner recorded (L.1 p.148). 9/24/1973 D.A. Ratiken RLS, Survey used corner. 9/26/1974 D.R. Gilchrist, Gove Assoc., survey shows cor. & wit. (L.5 p.276). 5/15/1975 W.Q. Smith RLS, Survey in Sec. 19 of Pine Grove shows corner (L.5 p.264). 12/12/1986 D.A. Ratiken RLS, Survey meas. N. 2635.54'.

SURVEY &
REMONUMENTATION

AUG 26 1993

COMMISSION