

**SURVEY &  
REMONUMENTATION**

**JAN 14 1998**

**LAND CORNER RECORDATION CERTIFICATE  
Filing Requirement of Act 74, Mich. P.A. 1970**

For corners in SECTION \_\_\_\_\_ Township

<u>Van Buren</u> (County)	Located In:	Corner Code #
1. Public Land Survey SW Corner, Sec 15	T <u>1S</u> R <u>13W</u>	<u>G-07 pm</u>
	T <u>   </u> R <u>   </u>	<u>   </u>
	T <u>   </u> R <u>   </u>	<u>   </u>
	T <u>   </u> R <u>   </u>	<u>   </u>
2. Property Controlling in Section	S <u>   </u> T <u>   </u> R <u>   </u>	<u>   </u>
	S <u>   </u> T <u>   </u> R <u>   </u>	<u>   </u>
3. Miscellaneous Property in Sec.	S <u>   </u> T <u>   </u> R <u>   </u>	<u>   </u>
	S <u>   </u> T <u>   </u> R <u>   </u>	<u>   </u>

**FILED**

Dec 5 9 01 AM '97

*Mark A. Smith*  
VAN BUREN COUNTY  
REGISTER OF DEEDS

Register of Deeds Stamp & File Number

4. Lot No. \_\_\_\_\_, Recorded Plat \_\_\_\_\_  
5. Private Claims \_\_\_\_\_

I, Donald R. Gilchrist in a field survey on Nov. 20, 1997 do hereby state that under requirements of P.A. 74, Michigan P.A. of 1970, the corner points mentioned in lines 1 and 2 above were in conformance with regulations and rules therefore as required in the current manual of survey instructions of the United States Department of the Interior, Bureau of Land Management or by a decree of a Court of Law and /or that the corner points mentioned in lines 3, 4 and 5 above were in conformance with the rules of the Michigan Board of Land Surveyors or by a Decree of a Court of Law; established, re-established, monumented, recovered, found as expressed below:

NOTE: Not more than 2 corners, all in the same town and range, may be recorded on this certificate.

1	A	B	C	D	E	F	G	H	I	J	K	L
2		6		5		4		3		2		1
3												
4		7		8		9		10		11		12
5												
6		10		17		16		15		14		13
7												
8		19		20		21		22		23		24
9												
10		30		29		28		27		26		25
11												
12		31		32		33		34		35		36
13												

A. Description of original monument and accessories and/or subsequent restoration:

**4/7/1830 - GOVERNMENT - R. Clark, Jr., D.S.**  
North between Sections 21 and 22 a distance of 80.00 chs (5280.00'), and set post corner.

**Witnesses:**

- 26" White Oak - N 55 Deg E - 32 lks (21.12')
- 27" White Oak - S 50 Deg E - 31 lks (20.46')

Distance East is 79.26 chs (5231.16') - 39.63 chs (2615.58').  
(Continued on back of Certificate)

B. Description of corner evidence found and/or method applied in restoring or reestablishing corner:


Found 1/2" pipe - Dug 3' - no stone.  
Road has been cut 6'.

This corner was approved at a Meeting of the Van Buren County Peer Group on 6/11/97 and is accepted as the best available evidence of the position of the original corner.

C. Description of monument for corner and accessories established to perpetuate locating the position of the corner:

- Set Harrison Marker in Monument Box.
- 3" pipe fence corner - South - 31.05'.
- 18" Hickory - S 45 Deg W - 43.34' N/W in NW Side.
- 22" Oak - N 5 Deg W - 50.58' N/W in W side.
- Centerline of Road is 10' North.

Ratified by Peer Group in  
accordance with P.A. 345 of 1990  
Van Buren County Surveyor  
Date D. R. A. 12/5/97

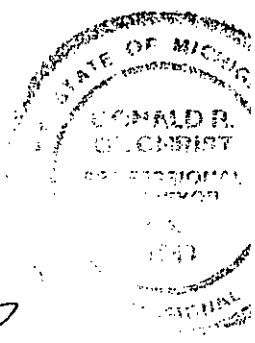

Signed by *Donald R. Gilchrist*  
Surveyor's Michigan License No. RLS #13583

Date 12/4/97

*11250 E. P...*

5/6/1898 - G. Muchler, C.S.  
Section 22.  
Book 5 - Page 76 & Red Book.  
Stone.

**Witnesses:**

4" Maple - N 58 Deg 30' W - 85 lks (56.10').  
10" Apple - N 27 Deg E - 105.5 lks (69.63').

10/24/1898 - Section 16.

Stone and evidence of witness tree to prove it.

Book 5 - Page 81 & Red Book.

Distance West is 20.27 1/8 chs (1337.90') to Eighth Post, and continued 1337.90' to Quarter Post for a total of 2675.80'.

Distance North is 20.03 chs (1321.98') to Eighth Post, and continuing North 1321.98' to Quarter Post for a total of 2643.96'.

1955+- - W. Q. Smith, C.S.

Notes.

Show corner.

1966 - Consumers Power Survey in Sections 15 & 16.

Drawing shows corner.

Distance North is 2646.38'.

Distance East is 2607.87'.

Distance West is 2673.77'.

**Witnesses:**

3" Pipe Fence Corner - South - 31'.  
12" Hickory - S 45 Deg W - 43.10'.  
14" Oak - N 5 Deg W - 50.92'.

5/26/1970

Notes.

Show corner (found pipe).

Distance West is 1336.77'.

12/13/1972 - D. A. Middleton, R.L.S. (Section 16).

Recorded Surveys (Liber 3 - Page 182) & (Liber 3 - Page 322).

Found 3/4" pipe.

**Witnesses:**

3" Pipe Fence Corner - South - 31'.  
12" Hickory - S 45 Deg W - 43.10'.  
14" Oak - N 5 Deg W - 50.92'.

Distance West is 1336.11', and continuing West 1336.27' to South Quarter Post for a total of 2672.22'.

Distance North is 1319.17', and continuing North 1319.17' to East Quarter Post for a total of 2638.34'.

12/13/1972 - Recordation Certificate (Liber 2 - Page 5).

Found 3/4" pipe and witnesses (same as above).

5/16/1973 - Field Notes.

Found corner.

6/20/1973 - Recorded Survey (Liber 4 - Page 99).

Same as above.

7/2/1973 - D. R. Gilchrist, R.L.S. (Section 21).

recorded Survey (Liber 4 - Page 30).

Found pipe and witnesses (same as above).

Distance West is 1336.11', and continuing West 1335.68' to Quarter Post for a total of 2671.79'.

Distance South is 2638.29' to Quarter Post.

7/17/1973 - Recorded Survey (Liber 5 - Page 26).

Same as above.

Distance North is 2638.21'.

Distance East is 2605.62'.

7/31/1974 - D. R. Gilchrist, C.S. (Gove).

Recorded Survey (Liber 5 - Page 161).

Section 16.

Distance West is 1336.11'.

Distance North is 2638.34'.