

SURVEY & REMONUMENTATION

JUN 14 1994

RECORDED

LIBER 4 PAGE 139

COMMISSION

LAND CORNER RECORDATION CERTIFICATE MAY 10 10 25 AM '94

Filing Requirement of Act 74, Mich. P.A. 1970

For corners in Pine Grove Township

Van Buren County (County)

Located In:

Corner Code #

Mark A. Smiths VAN BUREN CO REGISTER OF DEEDS

7.00

- 1. Public Land Survey T 1S R 13W M-13 SE Corner Sec 36
2. Property Controlling in Section S T R
3. Miscellaneous S T R Donald R. Gilchrist April 22, 1994

Register of Deeds Stamp & File Number

05/10 0101 10SURVEY

- 4. Lot No. Recorded Plat
5. Private Claims

I, in a field survey on 19 do hereby certify that under requirements of P.A. 74, Michigan P.A. of 1970, the corner points mentioned in lines 1 and 2 above were in conformance with regulations and rules therefore as required in the current manual of survey instructions of the United States Department of the Interior, Bureau of Land Management or by a decree of a Court of Law and/or that the corner points mentioned in lines 3, 4 and 5 above were in conformance with the rules of the Michigan Board of Land Surveyors or by a Decree of a Court of Law; established, re-established, monumented, re-monumented, recovered, found as expressed below:

NOTE: Not more than 4 corners, all in the same town and range, may be recorded on this certificate.

A. Description of original monument and accessories and/or subsequent restoration:

- 5/1827 - GOVERNMENT - W. Brookfield, D.S. Ran North on East line of Section 1, T 2 S, R 13 W a distance of 80.00 chs. & set temporary 6 mile Post.
12/26/1901 - W.H. Goss, C.S. Book 1 Page 106 - Set piece of 2" gas pipe 4.35' long by old stake. Book 6 Page 100, Red Book (Co. Surveyor Card) - West 39.895 chs. (2633.07') to 1/4 Post (1 1/2" Gas Pipe).
8/1971 - P.I. McPherson, R.L.S. (Consumers Power Co.). Found 2" Pipe 1.5' above grade. Witnesses - 1.5' East of N & S Fence; 15'± South of center line of 6' Drain. Drain runs N & W. Measured N 89°43'50" E 2633.00' to South 1/4 Post of Section 36 in Pine Grove Township.

B. Description of corner evidence found and/or method applied in restoring or reestablishing corner.

Fd 2" pipe sticking 1.5' above ground 4.3' long. 1.5' East of down fence cor post 15'± S. CL ditch W on CL ditch N. Set Harrison Marker.


Approved at the 4/22/94 Van Buren County Peer Group Meeting and is accepted as a careful and faithful perpetuation of the position of the Original Government Corner.

Ratified by Peer Group in accordance with P.A. 345 of 1990 Van Buren County Surveyor

Date 4/22/94 [Signature]

C. Description of monument for corner and accessories established to perpetuate locating the position of the corner:

- Harrison Marker
Set Sur. Marker Post 1's.
Ditch calls are same as above.
16" ash - N 5°W - 23.25' to Pk/N in W. Side
10" ash - West - 29.36' to Pk/N in S. Side
20" map - S 15° E - 30.65' to Pk/N in W. Side
18" ash - S 45° E - 32.98 to Pk/N in SW. Side

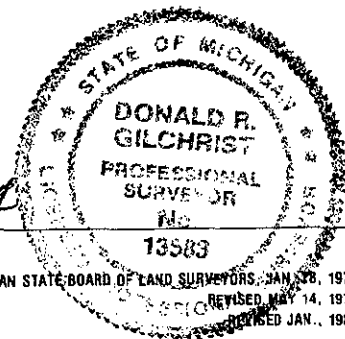

Signed by Donald R. Gilchrist Date 5/9/94

Surveyor's Michigan License No. Donald R. Gilchrist, RLS #13583