

FILED

MAY 16 1997

COMMISSION

LAND CORNER RECORDATION CERTIFICATE  
Filing Requirement of Act 74, Mich. P.A. 1970

DEC 10 8 24 AM '96

For corners in Bloomington Township

*Mark A. Smith*  
VAN BUREN CO.  
REGISTER OF DEEDS

9.00

Van Buren (County) Located In: Corner Code 77

1. Public Land Survey SW Corner Section 29	T <u>1S</u> R <u>14W</u>	<u>C-11</u>
	T _____ R _____	_____
	T _____ R _____	_____
	T _____ R _____	_____
2. Property Controlling in Section	S _____ T _____ R _____	_____
	S _____ T _____ R _____	_____
3. Miscellaneous Property in Sec.	S _____ T _____ R _____	_____
	S _____ T _____ R _____	_____

4. Lot No. \_\_\_\_\_, Recorded Plat \_\_\_\_\_

5. Private Claims \_\_\_\_\_

Register of Deeds Stamp & File Number

3724 127 09 0101 10SURVEY

A	B	C	D	E	F	G	H	I	J	K	L
2	6	5	4	3	2	1					
3											
4	7	8	9	10	11	12					
5											
6	18	17	16	15	14	13					
7											
8	19	20	21	22	23	24					
9											
10	30	29	28	27	26	25					
11											
12	31	32	33	34	35	36					
13											

Donald R. Gilchrist, in a field survey on 10-24, 19 96, do hereby certify that under requirements of P.A. 74, Michigan P.A. of 1970, the corner points mentioned in lines 1 and 2 above were in conformance with regulations and rules therefore as required in the current manual of survey instructions of the United States Department of the Interior, Bureau of Land Management or by a decree of a Court of Law and/or that the corner points mentioned in lines 3, 4 and 5 above were in conformance with the rules of the Michigan Board of Land Surveyors or by a Decree of a Court of Law; established, re-established, monumented, re-monumented, recovered, found as expressed below:

NOTE: Not more than 4 corners, all in the same town and range, may be recorded on this certificate.

A. Description of original monument and accessories and/or subsequent restoration:

**1/1830 - GOVERNMENT - R. Clark, Jr., D.S.**

Ran North between Sections 31 and 32 a distance of 80.00 chs. (5280.00') and set post corner

Witnesses:

18" Beech - N. 54° E. - 25 lks. (16.5')

22" Beech - S. 54° W. - 33 lks. (21.78')

Distance West is 40 chs. (2640.00') to Quarter Post.

Distance East is 79.83 chs. (5268.78')

B. Description of corner evidence found and/or method applied in restoring or reestablishing corner:


Found 7/8" Iron x 3' in mon. box - hit stone  
This corner approved at the 6/26/96 V.B. Co. Peer Group

Ratified by Peer Group in accordance with P.A. 345 of 1990  
Van Buren County Surveyor

Date 12/19/96 *D. R. Gilchrist*

C. Description of monument for corner and accessories established to perpetuate locating the position of the corner:

Set Harrison Marker in mon. box  
 28" Wal - N50° E - 64.63' nail in N. side  
 52" Map - N30° W - 97.23 nail in E. side  
 40" Map - S45° W - 55.88 Ackley's old wit nail in E. side  
 P.P. - S50° E - 107.83' nail N.E. side  
 2.5 N of centerline E&W Rd  
 2 ± W of centerline N&S Rd

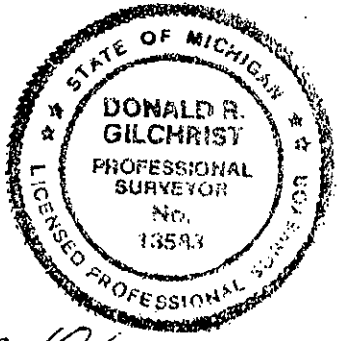

Signed by *Donald R. Gilchrist* Date 12/16/96  
 Surveyor's Michigan License No. RLS 13583

LIBET CL PAGE 397

4/28/1881 - C. D. Lawton, C.S.

Section 30

Book 3 - Page 121 & Red Book

Commenced at stone at Southeast Corner and ran S.  $88^{\circ} 33'$  W. to Quarter Post - put in an iron pipe at corner - 39.915 chs. (2634.28') (Ran N.  $24^{\circ} 15'$  W. to stone at Quarter Post - 39.955 chs. (2637.03')

5/28/1906 - W. H. Goss, C.S.

Section 29

Book 7 - Page 48

Found stone

4/23/1907 - W. V. Ackley, C.S.

Section 31

Book 7 - Page 120 & Red Book

Found Stone

**Witnesses:**

18" Sugar - SW. - 84.5 lks. (55.77')

18" Sugar - NW. - 67 lks. (44.22')

4/1966 - W. Q. Smith, C.S. - P.L.C. Party Chief

Section 31

Red Book

Found Stone with "X" - set iron over

1966 - Consumers Power Co. Survey

Sections 31 and 32

Distance West is 2637.08'

Distance South is 2639.87'

Distance East is 2631.16'

Angle South to East is  $89^{\circ} 54' 10''$

Angle South to West is  $90^{\circ} 38' 34''$

*LIBER 4 PAGE 398*