

liber 4 Page 306

LAND CORNER RECORDATION CERTIFICATE
Filing Requirement of Act 74, Mich. P.A. 1970

For corners in **Bloomington Township**

Van Buren County
(County)

Located In:

Corner Code #

FILED

Nov 14 11 48 AM '95

Mark A Smith
VAN BUREN CO.
REGISTER OF DEEDS

Register of Deeds Stamp & File Number

- 1. Public Land Survey T 1SR14W E-9
SW Corner Sect. 21 T R
T R
T R
- 2. Property Controlling S T R
in Section S T R
- 3. Miscellaneous S T R
Property in Sec. S T R

- 4. Lot No. _____, Recorded Plat _____
- 5. Private Claims _____

	A	B	C	D	E	F	G	H	I	J	K	L
2	6		5		4		3		2		1	
3												
4	7		8		9		10		11		12	
5												
6	18		17		16		15		14		13	
7												
8	19		20		21		22		23		24	
9												
10	30		29		28		27		26		25	
11												
12	31		32		33		34		35		36	
13												

Donald R. Gilchrist

October 12

95

I, Donald R. Gilchrist, in a field survey on October 12, 1995, do hereby certify that under requirements of P.A. 74, Michigan P.A. of 1970, the corner points mentioned in lines 1 and 2 above were in conformance with regulations and rules therefore as required in the current manual of survey instructions of the United States Department of the Interior, Bureau of Land Management or by a decree of a Court of Law and/or that the corner points mentioned in lines 3, 4 and 5 above were in conformance with the rules of the Michigan Board of Land Surveyors or by a Decree of a Court of Law; established, re-established, monumented, re-monumented, recovered, found as expressed below:

NOTE: Not more than 4 corners, all in the same town and range, may be recorded on this certificate.

A. Description of original monument and accessories and/or subsequent restoration:

1830 Government - R. Clark, Jr. D.S. North between Sections 28 and 29 a distance of 80.00 chs. (5280.00') and set Post Corner. Witnesses: 10" Beech N. 63°E - 11 lks. (7.26'). 28" Sycamore N.68° W - 2 lks. (1.32'). 6/ /1923 - T.A. Smith, C.S. County Highway Notes show a Stone 14' from Walnut Tree. 11/17/1950 - "Found Stone 14' East of Walnut". 1961 Van Buren Co. Road Commission Plans STA = 212 + 34; 20" tree - SE-41.7'; 15" Tree S50°E - 83.8; P.P. - N50°W - 60.4'. CONTINUED ON REVERSE

B. Description of corner evidence found and/or method applied in restoring or reestablishing corner:


Found Iron in monument box - removed - set Slimline Harrison Marker in monument box. Approved at the July 5, 1995 Van Buren County Peer Group Meeting and is accepted as a careful and faithful re-establishment of the position of the Original Government Corner.

Ratified by Peer Group in accordance with P.A. 345 of 1990
Van Buren County Surveyor

Date 7/5/95 D.R.G.

C. Description of monument for corner and accessories established to perpetuate locating the position of the corner:

Set Slimline Harrison Marker in monument box.
Concrete fence post - East 30.52' "X" in North side
P.P. N65°E - 41.08' pk/w in North side
24" Whiteoak - S40°E 63.75' pk/w in West side
Fence Post - West - 32.70'
P.P. N30°W 62.15' pk/w in East side
1' East of Centerline of Road

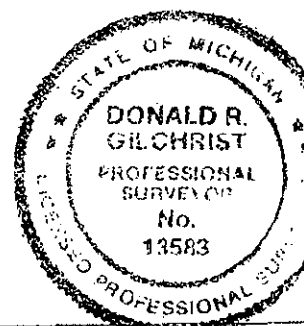

Signed by Donald R. Gilchrist

Date 11/14/95

Surveyor's Michigan License No. Donald R. Gilchrist, RLS #13583

Liber 4 Page 307

6/12/1973 - W. Q. Smith, C.S.

Section 21.

Recorded Survey (Liber 3 - Page 23).

Angle North to East is 90 Deg. 43'- 43".

"Set Iron in center of empty Monument Box". Box is in center line of road.

Witnesses:

R/W Iron 33' East.

Concrete Post 30.5' East to Center Line.

Old Fence East and West.

5/18/1973 - Recordation Certificate (Liber 2 - Page 97). Same witnesses as W. Q. Smith.

8/11/1973 - Recorded Survey (Liber 4 - Page 197) in Section 20.

Distance West to Quarter Post is 2623.71'.

Distance North is 1321.13' to Eighth Post, and continuing North 1321.13' to West Quarter Post for a total of 2642.26'. Same witnesses as W. Q. Smith.

9/4/1973 - Recorded Survey (Liber 4 - Page 33). Same witnesses as W. Q. Smith.

10/30/1973 - Recorded Survey (Liber 4 - Page 199).

Distance North is 1321.13' to Eighth Post, and continuing North 1321.13' to West Quarter Post for a total of 2642.71'. Same witnesses as W. Q. Smith.