

JAN 17 1996

Liber 4 Page-298

COMMISSION

LAND CORNER RECORDATION CERTIFICATE  
Filing Requirement of Act 74, Mich. P.A. 1970

For corners in Bloomington Township

FILED

Van Buren County Located In: Corner Code #

- 1. Public Land Survey T 1S R 14W E-13  
SW Corner Section 33 T \_\_\_\_\_ R \_\_\_\_\_
- 2. Property Controlling S \_\_\_\_\_ T \_\_\_\_\_ R \_\_\_\_\_  
in Section S \_\_\_\_\_ T \_\_\_\_\_ R \_\_\_\_\_
- 3. Miscellaneous S \_\_\_\_\_ T \_\_\_\_\_ R \_\_\_\_\_  
Property in Sec. S \_\_\_\_\_ T \_\_\_\_\_ R \_\_\_\_\_

Nov 14 11 48 AM '95

*Mark A. Smith*  
VAN BUREN CO.  
REGISTER OF DEEDS

Register of Deeds Stamp & File Number

- 4. Lot No. \_\_\_\_\_, Recorded Plat \_\_\_\_\_
- 5. Private Claims \_\_\_\_\_

	A	B	C	D	E	F	G	H	I	J	K	L
2	6	5	4	3	2	1						
3												
4	7	8	9	10	11	12						
5												
6	18	17	16	15	14	13						
7												
8	19	20	21	22	23	24						
9												
10	30	29	28	27	26	25						
11												
12	31	32	33	34	35	36						
13												

I, Donald R. Gilchrist, a field survey on 10/10, 19 95, do hereby certify that under requirements of P.A. 74, Michigan P.A. of 1970, the corner points mentioned in lines 1 and 2 above were in conformance with regulations and rules therefore as required in the current manual of survey instructions of the United States Department of the Interior, Bureau of Land Management or by a decree of a Court of Law and/or that the corner points mentioned in lines 3, 4 and 5 above were in conformance with the rules of the Michigan Board of Land Surveyors or by a Decree of a Court of Law; established, re-established, monumented, re-monumented, recovered, found as expressed below:

NOTE: Not more than 4 corners, all in the same town and range, may be recorded on this certificate.

A. Description of original monument and accessories and/or subsequent restoration:

See Reverse

B. Description of corner evidence found and/or method applied in restoring or reestablishing corner:

Fd wash machine crank in monument box, removed, dug hole and hit stone. Set a 20" Slimline Harrison Marker in monument box.


Approved at the May 3, 1995 Van Buren County Peer Group Meeting and is accepted as a careful and faithful perpetuation of the position of the Original Government Corner.

Ratified by Peer Group in accordance with P.A. 345 of 1990  
Van Buren County Surveyor

Date 5/3/95 D. R. G.

C. Description of monument for corner and accessories established to perpetuate locating the position of the corner:

Slimline Harrison Marker in monument box.  
Guy Pole South 50° East - 74.94' pk/w in Northeast side  
30" Locus - North 70° East - 68.93' pk/w in Southeast side  
P.P. - South 40° West - 40.37' pk/w in North side.  
Centerline of Road North 1' East  
On centerline East and West  
Waverly Corner - East- 49.42'  
Measured North to Northwest Corner, Section 33, Dist = 5279.6  
2639.52'.

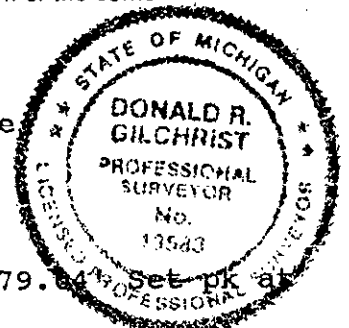

Signed by Donald R. Gilchrist Date 11/14/95

Surveyor's Michigan License No. Donald R. Gilchrist, RLS #13985 APPROVED BY MICHIGAN STATE BOARD OF LAND SURVEYORS, JAN. 28, 19 REVISED MAY 14, 19 REVISED JAN., 19

1827 - GOVERNMENT - William Brookfield, D.S.

West on South boundary of Section 33 a distance of 80.00 chs. (5280.00') and set Post Corner.

Witnesses:

- 6" Beech - N. 73 Deg. E. - 15 lks. (9.90').
- 6" Beech - N. 29 Deg. 30' W. - 12 lks. (7.92).

Jog is 75 lks. (49.5') East to Waverly Corner.



9758 11/14 0105 10SURVEY 9.00

12/1881 - C. D. Lawton, C.S.

Book 3 - Page 125 (Section 32).

At intersection of quarter lines, set the Center Quarter Post.

10/1899 - G. Muchler, C.S.

(Section 4 of Waverly Township).

Found Stone.

Distance East 23.7275 chs. (1566.02') and continued East to North Quarter Post 16.555 chs. (1092.63') for a total of 2658.65'.

Distance South to Quarter Post is 42.095 chs. (2778.27').

9/1952 - T. A. Smith, C.S.

W. Q. Smith field work (Section 32).

"Waverly corner - Stone - set Railroad Spike from old witnesses & doubled distance to North Quarter Post through Eighth Post".

Jog is 49.5'.

Distance West in Waverly Township is 2642'.

Distance West (figured) 2591' for Bloomingdale Township.

Distance North to Eighth Post is 1320.3', and continuing North 1320.3' to Railroad Spike in line with fence West and center line of Road for a total of 2640.60'.

Angle West to North is 89 Deg. 55'.

1966 - W. Q. Smith, C.S.

(D. R. Gilchrist field work) - (Sections 32 and 33) - (Consumers Power Survey).

Notes:

"Found Stone with "X" on it in a monument box".

Distance East to Quarter Post (found 1/2' pipe over stone) is 2634.57'.

Distance West to Quarter Post (found stake down 4' - set PK over) is 2626.11'.

Distance North to (PK by D. Pierce) Quarter Post is 2648.38', and continuing North 2630.29' (Consumers Power used as quarter distance) for total of 5278.67'.

Angle West to North is 89 Deg. 56' 05".

Angle East to North is 89 Deg. 56' 20".

9/4/1976 - D. R. Gilchrist, C.S.

(Gove) (Section 33).

Recorded Survey - (Liber 6 - Page 239).

Found iron in monument box.

Witnesses:

- 60D Power Pole - SW. - 40.70'.
- CL St. Sign - SE. - 66.45'.
- Corner in CL E. & W. Road 12' +/- West.
- CL N. & S. Road.

Distance East to Quarter Post is 2634.86'.

Distance North to Quarter Post is 2648.62'.

Angle North to East is 89 Deg. 56' 30".

1/12/1977 - Recordation Certificate (Liber 2 - Page 471).

Found iron in monument box and witnesses (same as above).