

1993

VAN BUREN COUNTY REMONUMENTATION PROGRAM

LAND CORNER RECORDATION CERTIFICATE

Filing Requirement of Act 74, Mich. P.A. 1970

Oct 19 11 52 AM '93

LIBER 4 REBENSION

For corners in

Van Buren (City of Gobles)	Located In: Bloomingdale Twp.	Corner Code # M-9
1. Public Land Survey Sec. 24	T <u>1</u> S. R <u>14</u> W.	<u>M-9</u>
	T _____ R _____	_____
	T _____ R _____	_____
	T _____ R _____	_____
2. Property Controlling in Section	S _____ T _____ R _____	_____
	S _____ T _____ R _____	_____
3. Miscellaneous Property in Sec.	S _____ T _____ R _____	_____
	S _____ T _____ R _____	_____

Mark A Smith
VAN BUREN CO
REGISTER OF DEEDS

Register of Deeds Stamp & File Number

10/17 0101 105URVEY

- 4. Lot No. _____, Recorded Plat _____
- 5. Private Claims _____

A	B	C	D	E	F	G	H	I	J	K
2	6	5	4	3	2	1				
3										
4	7	8	9	10	11	12				
5										
6	18	17	16	15	14	13				
7										
8	19	20	21	22	23	24				
9										
10	30	29	28	27	26	25				
11										
12	31	32	33	34	35	36				
13										

I, John C. Hunt, P.S.; in a field survey on Aug. 13, 19 93, do hereby certify that under requirements of P.A. 74, Michigan P.A. of 1970, the corner points mentioned in lines 1 and 2 above were in conformance with regulations and rules therefore as required in the current manual of survey instructions of the United States Department of the Interior, Bureau of Land Management or by a decree of a Court of Law and/or that the corner points mentioned in lines 3, 4 and 5 above were in conformance with the rules of the Michigan Board of Land Surveyors or by a Decree of a Court of Law; established, re-established, monumented, re-monumented, recovered, found as expressed below:

NOTE: Not more than 4 corners, all in the same town and range, may be recorded on this certificate.

A. Description of original monument and accessories and/or subsequent restoration:

5/1827 Gov. Survey: Wm. Brookfield d DS: N. on E. boundary 80 ch., set post cor. to Sec. 24 & 25 wit.: 14" White Oak S.17°W. 17 lks. (11.22'), 14" White Oak N.28°W. 35 lks. (23.10'). 10/5/186 CJ Monroe CS: Bk. 1 p.19: "At all the US Posts, I set stake & 3 stones around (sec. 13 & 24)" 4/28/1870: Vill. of Gobleville was laid out. 3/16&23/1874 AJ Teed CS: Ran 1/2 lines of Sec. 2 (NE cor. Sec. 25 butt of Liberty Pole on cor.). 7/8/1891 FP Lawton CS: Bk. 4 p.151: SE cor Sec. 24 Stake, meas. W. 20.11 1/2 ch. Set Stone & Brick at 1/8 post, cont. on to 1/4 post: Stone 20.11 1/2 ch. (1327.59' & 1/2 mi. = 2655.18'). Red Book Sec. 24 & 25: Have the Gov. jog of .18 ch (11.88') crossed out, & .23 1/2 ch. (15.40') written in; angle W. to S. = 90°52'; angle W. to N 89°05'. 2/8/1939 TA Smith CS: He used Pine Grove cor. 3/27/1939 meas. W. 21.81 1/2 ch. (1439.79 & cont. 18.50 ch. (1221.0'), total 2660.79'. 10/17/1945 used Pine Grove Cor.; angle N. to E

B. Description of corner evidence found and/or method applied in restoring or reestablishing corner: (Cont. on back)

M-9 Corner common to Sections 24 & 25, T15-R14W, Bloomingdale Township, City of Gobles. Corner evidence found: 1/2" iron rod over 1" iron pipe in mon box in C/L of road North, South, West, and 15.4' South of C/L road to East. Removed iron rod and iron pipe and set Harrison Marker.


THIS GOVERNMENT MONUMENT WAS RESTORED WITH APPROVAL OF THE VAN BUREN COUNTY REMONUMENTATION PEE GROUP OF SURVEYORS AT A MEETING HELD ON JULY 28, 1993, AND IS ACCEPTED AS A CAREFUL AND FAITHFUL PERPETUATION OF THE POSITION OF THE ORIGINAL CORNER.

C. Description of monument for corner and accessories established to perpetuate locating the position of the corner:

M-9 HARRISON MARKER IN MONUMENT BOX

- North 15.4' Harrison Marker in mon box.
- N.40°W. 43.00' set nail & washer in SW face of pole.
- N.20°E. 65.20' MSHD nail & washer in NW face of pole.
- N.70°E. 68.20' MSHD nail & washer in N. face of pole.
- S.30°W. 43.27' C/L fire hydrant.

Signed by John C. Hunt, P.S. Date Oct. 16, 1993
Surveyor's Michigan License No. 23513

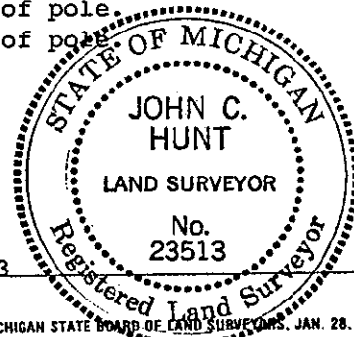

LIBER 4 PAGE 62

(Continued from front:)

89°47'30".

10/10/1955 WQ Smith CS: used Pine Grove cor. 4/22/1956 used Pine Grove Cor. Shows angle N. to E. 89°47'30". Jog 13.9 + 1.1' = 15'. 4/10/1957 used Bloomingdale cor. for survey West. 7/28/1960 used Pine Grove Cor. He shows jog wrong (10.78' + 1.1' = 11.88').

9/9/1966 DR Gilchrist RLS: shows survey in SW quad.; angle W. to S. = 90°52'30". 11/29/1966 used Bloomingdale cor.; angle W. to N. = 89°04'30". 1966 shows cor. in survey in Pine Grove Twp.; angle S. to E. = 90°12'20". 6/19/1974 Rec. Cert. L.2 p.267.

2/4/1977 AH McMachen RLS: survey shows cor. 2/15/1977 Rec. Cert. L.2 p.517.

10/28/1988 DR Gilchrist CS: Survey shown pine Grove Cor.

6/5/1992 Wightman & Moored used Bloomingdale corner in survey.