

**SURVEY & REMONUMENTATION**

FILED

JAN 14 1998

**VAN BUREN COUNTY REMONUMENTATION  
LAND CORNER RECORDATION CERTIFICATE  
Filing Requirement of Act 74, Mich. P.A. 1970**

DEC 16 12 00 PM '97

For corners in SECTION located in: Corner ID #  
VAN BUREN COUNTY COLUMBIA TWP. SW COR. SEC 18 T1S, R15W

*Mark A. Smith*  
VAN BUREN COUNTY  
SURVEYOR

- 1. Public Land Survey T 1S R 15W A-7  
T R  
T R  
T R
- 2. Property Controlling in Section S T R  
S T R
- 3. Miscellaneous S T R  
Property in Sec. S T R
- 4. Lot No. Recorded Plat
- 5. Private Claims

*Liber 5 PAGE 48*

Register of Deeds Stamp & File Number

I, Alan Bartlett in a field survey on November 25 1997 hereby certify that under requirements of P.A. 74, Michigan P.A. of 1970, the corner points mentioned in lines 1 and 2 above were in conformance with regulations and rules therefore as required in the current manual of survey instructions of the United States Department of the Interior, Bureau of Land Management or by a decree of a Court of Law and/or that the corner points mentioned in lines 3, 4 and 5 above were in conformance with the rules of the Michigan Board of Land Surveyors or by a Decree of a Court of Law; established, re-established, monumented, re-monumented, recovered, found as expressed below:

A	B	C	D	E	F	G	H	I	J	K	L	M
2	8	5	4	3	2	1						
3												
4	7	8	9	10	11	12						
5												
6	18	17	16	15	14	13						
7												
8	19	20	21	22	23	24						
9												
10	30	29	28	27	26	25						
11												
12	31	32	33	34	35	36						
13												

NOTE: Not more than 4 corners, all in the same town and range, may be recorded on this certificate.

A. Description of original monument and accessories and/or subsequent restoration:

(PLEASE SEE BACK OF PAGE)

**Ratified by Peer Group in  
accordance with P.A. 345 of 1990  
Van Buren County Surveyor**

Date D. R. S. 12/16/97

B. Description of corner evidence found and/or method applied in restoring or reestablishing corner:

FOUND 3/4" IRON BAR IN MONUMENT BOX @ CENTER LINE N/S ROAD AND 15.9' SOUTH OF CENTER LINE OF E/W ROAD.

WITNESSES	
N42°E 66.89'	P.K. NAIL IN WEST SIDE OF POWER POLE
N45°E 65.98'	CENTER OF TELEPHONE RISER
S45°E 61.55'	CENTER OF TELEPHONE RISER
S65°W 47.90'	CENTER OF TELEPHONE RISER
N15°W 98.51'	DOUBLE HEADED NAIL WEST SIDE OF P.P.


VERIFIED CORNER USING EXISTING WITNESSES. THIS GOVERNMENT MONUMENT WAS RESTORED WITH APPROVAL OF THE VAN BUREN COUNTY REMONUMENTATION PEER GROUP OF SURVEYORS NOVEMBER 19TH 1997.

C. Description of monument for corner and accessories established to perpetuate locating the position of the corner:

SET 2 1/2" DIAMETER HARRISON MONUMENT 0.5' DOWN IN MONUMENT BOX @ CENTERLINE OF N/S ROAD AND 15.9' SOUTH OF CENTER LINE OF E/W ROAD.

WITNESSES	
N42°E 66.89'	P.K. NAIL IN WEST SIDE OF POWER POLE
N45°E 65.98'	CENTER OF TELEPHONE RISER
S45°E 61.55'	CENTER OF TELEPHONE RISER
S65°W 47.90'	CENTER OF TELEPHONE RISER
N15°W 98.51'	DOUBLE HEADED NAIL WEST SIDE OF P.P.
NORTH 27.06'	NE CORNER SECTION 24 (M-7 T1S, R16W)

CORNER IS ACCEPTED AS A CAREFUL AND FAITHFUL PERPETUATION OF THE POSITION OF THE ORIGINAL CORNER

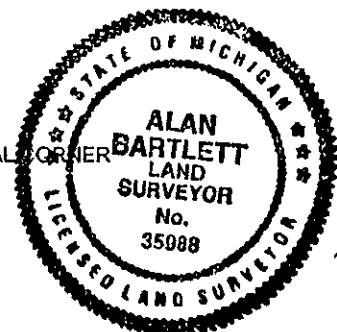

Signed by Alan K. Bartlett  
Surveyor's Michigan License No. 35988

Date 12/15/97

*Liber 5 Page 49*

A-7      SOUTHWEST CORNER OF SECTION 18 T1S, R15W COLUMBIA TWP.

1830      WEST BETWEEN SECTION 18 AND 19  
18 AND 19      73.36 CHAINS INTERSECTED WEST BOUNDARY 41LKS(27.06') SOUTH OF POST. SET POST AT INTERSECTION CORNER TO SECTIONS

WITNESSES		
BEECH 10"	N121/2°E	20 LINKS
BEECH 10"	S48°E	48 LINKS

6/1972      LCRC LIBER 1, PAGE 458 MITCHELL  
FOUND STONE CALLED FOR IN FIELD NOTES AT COUNTY SURVEYORS OFFICE. SET 1" IRON PIPE OVER STONE.

WITNESSES		
POWER POLE N15°W	98.45'	
POWER POLE N45°E	66.52'	
TELE. CAB. BOX S45°W	60.80'	

6/1972      RECORDED SURVEY LIBER 2, PAGE 91 ALPHA/MITCHELL  
ANGLE N TO E 90°00'00" DISTANCE NORTH 2642.48'  
DISTANCE EAST 882.27+1320.00 = 2202.27'  
FOUND STONE SET 1" IRON PIPE OVER IT.

WITNESSE		
N15°W	98.45'	POWER POLE
N45°E	66.52'	POWER POLE
S45°E	60.80'	TELE. CABLE BOX

8/1973      RECORDED SURVEY LIBER 4, PAGE 76 ALPHA/MITCHELL  
1" PIPE WITNESSES THE SAME.  
GRIMES DRAIN DESC.  
S89°W 4.40 CHAINS TO THE HIGHWAY 5.72 CHS. SOUTH FROM THE NORTHWEST CORNER OF SECTION 19.

11/17/1997      LANDMARK TECH. ALAN BARTLETT RLS#35988  
FOUND 3/4 " IRON BAR IN MONUMENT BOX CENTER LINE ROAD 15.9' NORTH

WITNESSES		
N42°E	66.89'	P.K. NAIL IN W SIDE OF P.P.
N45°E	65.98'	CENTER OF TELEPHONE RISER
S45°E	61.55'	" "
S65°W	47.90'	" "
N15°W	98.51'	DBL HEADED NAIL W SIDE P.P.
NORTH	27.06'	NE CORNER SECTION 24 (M7 T1S,R16W)