

COMMISSION

LAND CORNER RECORDATION CERTIFICATE 18 9 2 AM '93
Filing Requirement of Act 74, Mich. P.A. 1970

For corners in Columbia Township

Van Buren
(County)

Located In:

Corner Code #


Mark A. Smith
VAN BUREN CO.
REGISTER OF DEEDS

- 1. Public Land Survey T 1S R 15W 3E
SW corner Section 4 T _____ R _____
T _____ R _____
T _____ R _____
- 2. Property Controlling S _____ T _____ R _____
in Section S _____ T _____ R _____
- 3. Miscellaneous S _____ T _____ R _____
Property in Sec. S _____ T _____ R _____

Register of Deeds Stamp & File Number

4. Lot No. _____, Recorded Plat _____

5. Private Claims _____

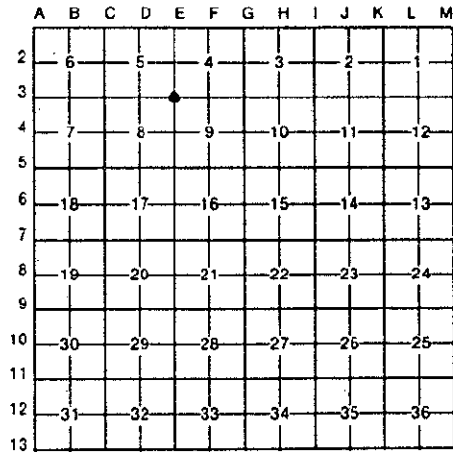

I, Donald R. Gilchrist in a field survey on 10/28, 19 93, do hereby certify that under requirements of P.A. 74, Michigan P.A. of 1970, the corner points mentioned in lines 1 and 2 above were in conformance with regulations and rules therefore as required in the current manual of survey instructions of the United States Department of the Interior, Bureau of Land Management or by a decree of a Court of Law and/or that the corner points mentioned in lines 3, 4 and 5 above were in conformance with the rules of the Michigan Board of Land Surveyors or by a Decree of a Court of Law; established, re-established, monumented, re-monumented, recovered, found as expressed below:

NOTE: Not more than 4 corners, all in the same town and range, may be recorded on this certificate.

A. Description of original monument and accessories and/or subsequent restoration:

2/1830 - GOVERNMENT - Robert Clark, Jr., D.S.
North between Sections 8 and 9 a distance of 80 ch. to Section Post
Corner to Sections 4, 5, 8 and 9
Witnesses - 9" Hemlock - S 12 Deg W - 17 lks.
40" Pine - N 43 Deg W - 6 lks.

("A" continued on back of Certificate)

B. Description of corner evidence found and/or method applied in restoring or reestablishing corner:

Fd Stone in Monument Box.
Olds Witnesses checked.
Set Harrison Marker over Stone in Monument Box
Approved at the County PeerX Group Meeting on 7/28/93 and is accepted as a careful and faithful perpetuation of the original Government Corner.

C. Description of monument for corner and accessories established to perpetuate locating the position of the corner:

Harrison Marker in Monument Box
SE Corner U.S. Post Office - N 45 Deg W - 62.93'.
Top CL catch basin - S 45 Deg W - 44.54'.
Top CL Catch basic - S 45 Deg E - 47.73'.
s4" Map - N 65 Deg E - 73.67'.
On CL - CL

Label 4 Pg 77



Signed by *Donald R. Gilchrist* Date 11/17/93
Surveyor's Michigan License No. Donald R. Gilchrist, RLS #13583

A. (continued from front of Certificate)

4/3/1871 - A.J. Pierce, C.S.
Layout of Grand Junction

5/12/ to 15/1897 - George Mutchler, C.S.
Book 5 - Page 64, Survey in Section 5.
Ran from Southeast corner (stone) West to Southwest corner (stone).
Quarter Post gone in plowed field, set Stake and Stone midway.
Set 1/8 Corner stakes at 19.97 ch. (1318.02'). Total mile =
5272.08', 1/2 mile - 2636.04'.
Ran North to West 1/4 Post of Section 4. It is some 5' in ground where
sand of hill had blown over it, and by witnesses set by Pierce
(Tamarack Stake) replaced it with Pine Stake 7' long to reach to
surface.
Measured 39.8825 ch. (2632.24').
Witnesses - 8" Sugar - N 49 Deg E - 51 lks.? (33.66').
8" Sugar - N 52 Deg 45' W - 71 lks. (46.86').

10/14/1929 - T.A. Smith, C.S.
NOTE: Shows Northeast corner Section 8 - South 515.46' to pipe.
Corner = Iron Pipe.
Witnesses - Fence Post - East - 23.7' to Cen. Line.
8" Maple - N 45 Deg W - 38.6' to Cen. Line.
3/29/1933 - Shows Section 8.
NOTE: Measured West 1318.4' to 1/8 Post, continued 1318.4' to 1/4
Post. Measured South 2637.55' to 1/4 Post and Mile = 5275.1'.
Measured South 495.5' to Center Line of RR Track. Angle West to
South = 90 Deg.
NOTE: Shows distance West 2637.3'
NOTE: Shows Angle West to South = 90 Deg and 495.5' to Center Line of
RR Track.
11/4/41 - Survey shows South 495.5' to Center Line of RR Track and
South 1318.78' to 1/8 post.

4/9/1958 - W.Q. Smith, C.S.
Survey Shows Corner - Note shows Measured North 2632.2' and Angle
North to East = 90 Deg 27'.
Note and Survey shows - Measured East 1313.4' to 1/8 Post, continued
1313.4' to 1/4 Post.
9/18/1959 - Shows Angle South to East = 90 Deg 09'30".
6/21/1965 - Shows Angle South to West = 90 Deg. Also 330' to Center
Line of Street.

5/26/1971 - D.A. Ratiken, R.L.S. and Allegan County Surveyor
Survey Shows Corner.
Witnesses - 28" Oak - N 35 Deg E - 29.7'.
3" Juniper - N 35 Deg W - 57.4'.
Telephone Box - S 40 Deg W - 39.2'.

11/15/1974 - A.H. McMachen, R.L.S.
Shows Corner. (1" Iron Rod).
Witnesses - SE Corner Post Office - N 45 Deg W - 74.43' (-10'?)
20" Maple - N 55 Deg E - 64.21'.
11/1974 - Corner Recordation Certificate - (L2,P401).

5/5/1977 - W.Q. Smith, R.L.S.
Note: Found pointed Stone down 12". Set Monument Box over. Also
found phoney corner, 1" iron bar to surface 1.30' South and 0.45'
West to true corner.
Witnesses - SE corner of Post Office - NW - 62.93'.
Top Center of Catch Basic Grate - SW - 44.53'.
Top Center of Catch Basic Grate - SE 47.73'.

7/30/1984 - J.C. Hunt, R.L.S.
Shows Corner.
Measured South 1319.25' to 1/8 Post.

Sheet 4 pg. 78