
## LAND CORNER RECORDATION CERTIFICATE Filing Requirement of Act 74, Mich. P.A. 1970


Van Buren		Located In:		Corner Code 44
1	Public Land Survey		T 1S R 16W T 1S R 16W T 1S R 16W	F-3 E-1 E-2
			T R	
2	Property Controlling	S	T R	
	in Section	S	, T R	
3.	Miscellaneous	S	T R	
	Occapato in Con	c	T D	

Register of Deeds Stamp & File Number

- I. Donald L. Bissell , in a field survey on May , 19 88 , do hereby certify that under requirements of P.A. 74, Michigan P.A. of 1970, the corner points mentioned in lines 1 and 2 above were in conformance with regulations and rules therefore as required in the current manual of survey instructions of the United States Department of the Interior, Bureau of Land Management or by a decree of a Court of Law and/or that the corner points mentioned in lines 3, 4 and 5 above were in conformance with the rules of the Michigan Board of Land Surveyors or by a Decree of a Court of Law; established, re-established, monumented, re-monumented, recovered, found as expressed below.

NOTE: Not more than 4 corners, all in the same town and range, may be recorded on this certificate.

 

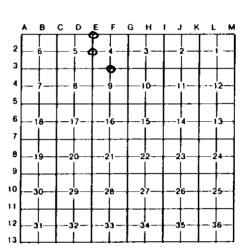

B. Description of corner evidence found and/or method applied in restoring or reestablishing corner:

Found PK Nail over boat spike

E-1 Found 3/4" iron bar E-2
Found 1" Pipe
24" Pine - NE - 53.12'
36" Maple - SW - 31.97'
P.P. West - 46.05'
Witnesses by Witchell Surveys, Inc.
# 19618

C Description of monument for corner and accessories established to perpetuate locating the position of the corner:

F-3
Si Sec. 4, T1S, R16W
Found P.K. Mail
Set: Mon. box over boat spike in pavt.
Power Pole NW 80.40'
Gas Main Sign N 44.06'
Guard Post SW 23.69'
10" Maple N41°E - 71.4'

E-2
Wi cor. Sec. 4, T1S, R16W
Found 1" Pipe
24" Twin Pine - NE - 53.12'
36" Maple - SW - 31.97'
Power Pole - West - 46.05'
12" Maple - N45°E - 38.35'
1 Payt. - East - 4.0'

Signed by Soval J. Buill Date

Surveyor's Michigan License No.

18655

APPROVED BY MICHIDAN STATE BOARD OF LAND SURVEYORS, JAN. 28, 197
REVISED MAY 14, 197