

1893

COMMISSION

LAND CORNER RECORDATION CERTIFICATE

NOV 18 9 28 AM '93

Filing Requirement of Act 74, Mich. P.A. 1970

For corners in Geneva Township

<u>Van Buren County</u> (County)	Located In:	Corner Code #
1. Public Land Survey	T <u>1S</u> R <u>16W</u>	<u>2E</u>
	T _____ R _____	_____
West 1/4 Post Sect 4	T _____ R _____	_____
	T _____ R _____	_____
2. Property Controlling in Section	S _____ T _____ R _____	_____
	S _____ T _____ R _____	_____
3. Miscellaneous Property in Sec.	S _____ T _____ R _____	_____
	S _____ T _____ R _____	_____

Mark A. Smith
VAN BUREN CO
REGISTER OF DEEDS

Register of Deeds Stamp & File Number

4. Lot No. _____, Recorded Plat _____

5. Private Claims _____

	A	B	C	D	E	F	G	H	I	J	K	L	M
2	6		5	4	3	2	1						
3													
4	7	8	9	10	11	12							
5													
6	18	17	16	15	14	13							
7													
8	19	20	21	22	23	24							
9													
10	30	29	28	27	26	25							
11													
12	31	32	33	34	35	36							
13													

I, Donald R. Gilchrist in a field survey on 11/11, 19 93, do hereby certify that under requirements of P.A. 74, Michigan P.A. of 1970, the corner points mentioned in lines 1 and 2 above were in conformance with regulations and rules therefore as required in the current manual of survey instructions of the United States Department of the Interior, Bureau of Land Management or by a decree of a Court of Law and/or that the corner points mentioned in lines 3, 4 and 5 above were in conformance with the rules of the Michigan Board of Land Surveyors or by a Decree of a Court of Law; established, re-established, monumented, re-monumented, recovered, found as expressed below:

NOTE: Not more than 4 corners, all in the same town and range, may be recorded on this certificate.

A. Description of original monument and accessories and/or subsequent restoration:


- 4/1830 - GOVERNMENT - R. Clark, D.S.
North between Sections 4 & 5, 40 chs. & set 1/4 Section Post.
- 1869 - A.J. Pierce, C.S.
Book 3 - Pages 86 to 89
Found old Stake, renewed, witness Stump remaining.
1870, Sections 4 & 5.
(continued on back of Certificate)

B. Description of corner evidence found and/or method applied in restoring or reestablishing corner:

Found 3/4" pipe and pieces of wood
Old 1939 Witness Maple checks
Set Harrison Marker in Monument Box
This corner approved at Peer Group Meeting of 10/27/1993 and is accepted as a careful and faithful perpetuation of the original Government Corner .

C. Description of monument for corner and accessories established to perpetuate locating the position of the corner:

- Set Harrison Marker in Monument Box
- 12" Maple - N 30 Degrees E - 38.30' to nail and tab North side
- P.P - West - 46.17' to nail North side
- 36" Maple - S 45 Degrees W - 32.05' tab and nail SE side
- 4' West of CL Road

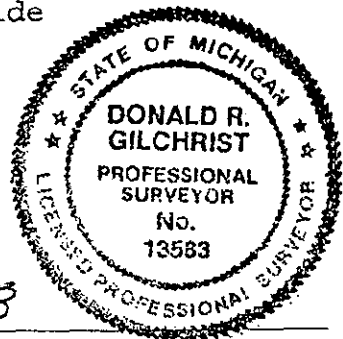

Signed by Donald R. Gilchrist Date 11/18/93
 Surveyor's Michigan License No. Donald R. Gilchrist, RLS #13583

A. Continued from front of Certificate

Measured North 43.18 chs. (2849.88) / 43.19 chs. (2850.54').
Measured South 39.82 chs. (2628.12').
Measured West to Center 1/4 Post 39.67 chs. (2618.22').
5/3/1872 - Measured North 43.30 chs. (2857.80').
Government - 43.37 chs. (2862.42').

10/6/1891 - F.P. Lawton, C.S.

Book 5 - Page 5.

Section 5 - Found Stone.

Measured West to Center 1/4 Post (Stake & Crockery) 39.73 chs.
/ (2622.18').

Measured South & set Stone at 9.95 chs. (630.30') and continued South
9.95 chs. (630.30') and set Stone.

4/11/1917 - W.H. Goss, C.S.

Red Book

Measured South 39.89 chs. (2632.74').

4/10/1939 - T.A. Smith, C.S.

Red Book

Found Pipe 3" below Black Top.

Witnesses - 20" Pine - N 70 Deg E - 32.7' to Center Line.

24" Maple - S 45 Deg W - 32.1' to Center Line

2/1/1957 - W.Q. Smith, C.S.

Survey shows corner.

Measured North 2859.4'

4/4/1960 - Found Iron Pipe 2.5' West of Center Line of Road.

Witnesses - 30" Maple - S 45 Deg W - 32.6'.

30" Pine - N 35 Deg E - 53.0'.

11/15/1971 - Robert Beland, R.L.S.

Survey Recorded (L1-P212), Found Iron Pipe.

Corner Recordation Certificate (L1-P218).

11/1/1984 - D.R. Gilchrist, C.S.

Survey shows Corner & Witnesses.

Measured South 2634.06'.

2/28/1989 - D.L. Bissell, R.L.S. (D.N.R.).

Corner Recordation Certificate (L2-P602).

No Witnesses, Found 5/8" Iron Rod.

End of A.

Label 4 pg. 80