

**SURVEY &  
REMONUMENTATION**

FILED

APR 25 1995

Nov 22 8 44 AM '94

**COMMISSION**

**LAND CORNER RECORDATION CERTIFICATE**

Filing Requirement of Act 74, Mich. P.A. 1970

For corners in Almena Township, W 1/4 Post, Sec 5

*Mark A. Smith*  
VAN BUREN CO  
REGISTERED DEEDS

<u>Van Buren County</u> (County)	Located In:	Corner Code #
1. Public Land Survey	T <u>2S</u> R <u>13W</u>	<u>2C</u>
	T _____ R _____	_____
	T _____ R _____	_____
	T _____ R _____	_____
2. Property Controlling in Section	S _____ T _____ R _____	_____
	S _____ T _____ R _____	_____
3. Miscellaneous Property in Sec.	S _____ T _____ R _____	_____
	S _____ T _____ R _____	_____

Register of Deeds Stamp & File Number

4. Lot No. \_\_\_\_\_, Recorded Plat \_\_\_\_\_  
5. Private Claims \_\_\_\_\_

	A	B	C	D	E	F	G	H	I	J	K	L
2	6	5	4	3	2	1						
3												
4	7	8	9	10	11	12						
5												
6	18	17	16	15	14	13						
7												
8	19	20	21	22	23	24						
9												
10	30	29	28	27	26	25						
11												
12	31	32	33	34	35	36						
13												

I, Donald R. Gilchrist, a field survey on October 21, 19 92, do hereby certify that under requirements of P.A. 74, Michigan P.A. of 1970, the corner points mentioned in lines 1 and 2 above were in conformance with regulations and rules therefore as required in the current manual of survey instructions of the United States Department of the Interior, Bureau of Land Management or by a decree of a Court of Law and/or that the corner points mentioned in lines 3, 4 and 5 above were in conformance with the rules of the Michigan Board of Land Surveyors or by a Decree of a Court of Law; established, re-established, monumented, re-monumented, recovered, found as expressed below:

NOTE: Not more than 4 corners, all in the same town and range, may be recorded on this certificate.

A. Description of original monument and accessories and/or subsequent restoration:

- Government (1830)  
Set Quarter Post at 40.00 ch.  
16" W. Oak - N 12 Deg 30' E - 18 lks.  
8" Beech - S 45 Deg 30' W - 7 lks.
- A.A. Fosdick (10/13/1884)  
Stone  
30" Pine Stump - S 34 Deg W - 63 lks.
- W.H. Goss (5/2/1917)  
(Same as Fosdick)

B. CONTINUED ON REVERSE  
Description of corner evidence found and/or method applied in restoring or reestablishing corner:


Field Checked by D.R. Gilchrist on 11/1/94  
Re-Approved by the Van Buren County Peer Group at the 11/2/94 Meeting

Ratified by Peer Group in  
accordance with P.A. 345 of 1990  
Van Buren County Surveyor

Date D.R.G. 11/21/94

C. Description of monument for corner and accessories established to perpetuate locating the position of the corner:

- Harrison Marker (#13583)  
1'± N of north edge of paving  
10" x 10" Conc Fen Post - N - 31.69 SE Cor  
6" Sass - N 30 Deg E - 35.91 Nail SE Side  
8" Maple - S 45 Deg E - 51.35 Nail NE Side  
IR. 43.5' South

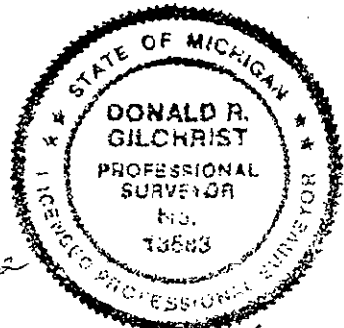

*License 4 page 192*

Signed by Donald R. Gilchrist Date 11/14/94

CONTINUED

Approved at 9/92 Peer Group Meeting  
FD 1/2" IR (Bent)  
Chked wit to Fen Post  
Chked to IR 43.5' South  
Set Harrison Marker

John Kester (5/30/1973)  
Found Stone & Crockery and set Iron over.  
I W & M Fd. Stone & Ironed Same  
Concrete Fence Post - N 5 Deg E - 31.72'  
8" Maple - S 20 Deg W - 31.72'  
Cen L 26th Avenue - South 9'.

George Mitchel (6/29/1977)  
Found 1" Iron.  
10" Elm - S 5 Deg W - 32.05'  
8" Elm - N 80 Deg W - 22.55'  
8' Pop - SE - 50.55'.  
John Hunt (1975 & 1978) Rec'd L-2, P-481.

Ray Moored (3/6/84)  
Found 1/2' Iron.  
Cen L 26th Ave - South 10' ±.  
SE Corner 10" x 10" Concrete Post - North - 31.55'  
P.K. Nail NE Side 13" Elm - N 75 Deg W - 22.27'.  
P.K. Nail E Side 11" Hickory - South 32.94'.

*Liber 4 page 193*