

Dec 10 4 45 PM '99

9.
2

LAND CORNER RECORDATION CERTIFICATE
Filing Requirement of Act 74, Mich. P.A. 1970

For corners in Almena Township

Van Buren County Located In: Corner Code #
(County)

- 1. Public Land Survey T 2S R 13W E-9
NW Corner, Sec 28
- 2. Property Controlling in Section S T R
- 3. Miscellaneous Property in Sec. S T R

LIBER 5 PAGE 262

9.00

12/10 0101 10SURVEY

Register of Deeds Stamp & File Number

- 4. Lot No. _____, Recorded Plat _____
- 5. Private Claims _____

I, Donald R. Gilchrist in a field survey on Dec. 3, 19 99 do hereby state that under requirements of P.A. 74, Michigan P.A. of 1970, the corner points mentioned in lines 1 and 2 above were in conformance with regulations and rules therefore as required in the current manual of survey instructions of the United States Department of the Interior, Bureau of Land Management or by a decree of a Court of Law and/or that the corner points mentioned in lines 3, 4 and 5 above were in conformance with the rules of the Michigan Board of Land Surveyors or by a Decree of a Court of Law; established, re-established, monumented, recovered, found as expressed below:

NOTE: Not more than 2 corners, all in the same town and range, may be recorded on this certificate.

A	B	C	D	E	F	G	H	I	J	K	L	M
1												
2	6		5		4		3		2		1	
3												
4	7		8		9		10		11		12	
5												
6	18		17		16		15		14		13	
7												
8	19		20		21		22		23		24	
9												
10	30		29		28		27		26		25	
11												
12	31		32		33		34		35		36	
13												

A. Description of original monument and accessories and/or subsequent restoration:

4/1830 - GOVERNMENT - G. W. Harrison, D.S.
Ran North between Sections 28 and 29 a distance of 80.00 chs. (5280.00') and set post corner.
Witnesses:
15" White Ash - N 25° 30' E - 42 lks. (27.72').
5" White Oak - S 48° W - 22 lks. (14.52').

(Continued on back of Certificate)

SURVEY & REM...

DEC 10 1999

B. Description of corner evidence found and/or method applied in restoring or reestablishing corner:

Found 1/2" pipe in Monument Box.


Approved at the 3/31/99 meeting of the Van Buren County Peer Group and is accepted as the best available evidence of the position of the original corner.

C. Description of monument for corner and accessories established to perpetuate locating the position of the corner:

Set Slim Line Harrison Marker IN MON BOX
U.P. - N 35° W 25.70' N/W S side.
16" Poplar - S 20° W - 60.19' N/W E side.
P.P. - S 20° E - 92.57' N/W W side.
8" Poplar - N 40° E - 123.99' N/W W side.
.5" E N&S Centerline.
2' S Centerline E.

Ratified by Peer Group in accordance with P.A. 345 of 1990
Van Buren County Surveyor

Date 12-10-99

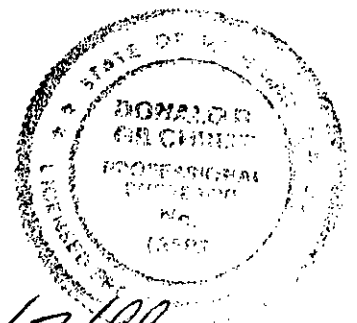

Signed by Donald R. Gilchrist

Date 12/7/99

Surveyor's Michigan License No. RLS 13583

8/1868 - C. D. Lawton, C.S.

Section 28

Book 2 - Page 62

Stake

Distance South is 39.89 chs. (2632.74').

7/14/1950 - W. Q. Smith, C.S.

Section 20

Field Note: Set pipe 2640.80' South of East Quarter Post in centerline of North and South Road.

4/9/1954 - Section 28.

Drawing shows corner.

3/22/1979 - A. H. McMachen, R.L.S.

Survey Drawing

Iron pipe in Monument Box.

Witnesses:

12" Poplar - S 20° W - 79.27'.

U. Pole - N 30° W - 25.79'.

St. Sign - N 30° E - 32.35'.

2/8/1988 - Survey Drawing

Pipe in Monument Box.

Witnesses:

U. Pole - N 35° W - 25.80'.

Stop Sign - N 75° E - 43.61'.

End C.M.P. - S 50° E - 43.96'.

Distance East is 2654.64'.

Distance South is 2652.90'.

SURVEY &
RECORDS DEPARTMENT

DEC 4 3 1999

SECTION