

NOV 16 1994

COMMISSION

LAND CORNER RECORDATION CERTIFICATE OCT 18 12 02 PM '94

LIBER 4 PAGE 158

Filing Requirement of Act 74, Mich. P.A. 1970

For corners in Almena Township

| | | |
|---|---|---------------|
| Van Buren County <small>(County)</small> | Located In: | Corner Code # |
| 1. Public Land Survey N ¼ Post Sec 10 | T 2S R 13W T _____ R _____ T _____ R _____ T _____ R _____ | 3-H |
| 2. Property Controlling in Section | S _____ T _____ R _____ S _____ T _____ R _____ | |
| 3. Miscellaneous Property in Sec. | S _____ T _____ R _____ S _____ T _____ R _____ | |

Mark A. Smith
VAN BUREN CO.
REGISTERED SURVEYOR

Register of Deeds Stamp & File Number

9.00
7361 10/18 0101 10SURVEY

- 4. Lot No. _____, Recorded Plat _____
- 5. Private Claims _____

| A | B | C | D | E | F | G | H | I | J | K | L | M |
|----|----|----|----|----|----|----|---|---|---|---|---|---|
| 2 | 6 | 5 | 4 | 3 | 2 | 1 | | | | | | |
| 3 | | | | 10 | 11 | 12 | | | | | | |
| 4 | 7 | 8 | 9 | | | | | | | | | |
| 5 | | | | | | | | | | | | |
| 6 | 18 | 17 | 16 | 15 | 14 | 13 | | | | | | |
| 7 | | | | | | | | | | | | |
| 8 | 19 | 20 | 21 | 22 | 23 | 24 | | | | | | |
| 9 | | | | | | | | | | | | |
| 10 | 30 | 29 | 28 | 27 | 26 | 25 | | | | | | |
| 11 | | | | | | | | | | | | |
| 12 | 31 | 32 | 33 | 34 | 35 | 36 | | | | | | |
| 13 | | | | | | | | | | | | |

1. Donald R. Gilchrist in a field survey on June 29, 1994

do hereby certify that under requirements of P.A. 74, Michigan P.A. of 1970, the corner points mentioned in lines 1 and 2 above were in conformance with regulations and rules therefore as required in the current manual of survey instructions of the United States Department of the Interior, Bureau of Land Management or by a decree of a Court of Law and/or that the corner points mentioned in lines 3, 4 and 5 above were in conformance with the rules of the Michigan Board of Land Surveyors or by a Decree of a Court of Law; established, re-established, monumented, re-monumented, recovered, found as expressed below:

NOTE: Not more than 4 corners, all in the same town and range, may be recorded on this certificate.

A. Description of original monument and accessories and/or subsequent restoration:

Government - set ¼ Post at 40.50 ch.; 14" Beech - S 30°30' W 13 lks; 8" Beech N 80° E 25 lks. A.A. Fosdick, Co.Surveyor (1/6/1883) Fd stake & one Gov't witness standing (should be stone); 10" Beech S 57°30' W 25.5 lks.; 18" Beech S 53° E 75 lks. W.H. Goss, Co.Surveyor (1899) Sleigh shoe; Gov't 14" Beech S 30°30' W 13 lks. T.A. Smith, Co.Surveyor (11/6/45) Drove pipe; 48" Beech S 57° W 9' to Cen L.; 16" Walnut N 48°30' W 41.9' to Cen L.; 3" Elm N 70° E 89.1' to Cen L. W.Q. Smith, Co.Surveyor (10/1/71) Found 3/4" pipe as set by T.A. Smith; 50" Beech S 57° E 9.18' to nail & washer SE side; 20" Walnut N 45° W 41.9' to Cen L.; 22" Walnut North 43.9' to Cen L.; (continued on back of Certificate)

B. Description of corner evidence found and/or method applied in restoring or reestablishing corner:


Found 3/4" Pipe - Down 1' - removed
Placed Harrison Marker
50" Beech Tree Gov't Witness is gone
Corner approved at Peer Group Meeting on 10/21/92, recorded in Liber 3, pages 255 & 256.
Corner was field checked on 6/22/94 by D.R. Gilchrist, Co.Surveyor.
Approved at the 6/29/94 Van Buren County Peer Group Meeting and is accepted as a careful and faithful perpetuation of the position of the Original Government Corner.

Retified by Peer Group in accordance with P.A. 345 of 1990
Van Buren County Surveyor

Date D. R. G. 10/18/94

C. Description of monument for corner and accessories established to perpetuate locating the position of the corner:

Harrison Marker
10" Maple - N 45° E 60.36' Nail SE side
P.P - N 20° W 70.36' Nail West side
24" Walnut - S 55° E 60.06' Nail N side
Steel Fence Post/Aluminum Tag Marked "20' North to ¼ Post" South 20'
23' East of Fen South
5' S of E Rd.

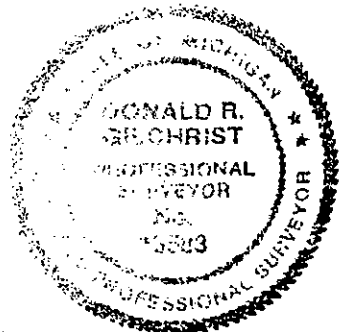

Signed by Donald R. Gilchrist Date 9/22/94
Surveyor's Michigan License No. Donald R. Gilchrist, RLS #13583

LIBER 4 PAGE 159

A. Continued from front of Certificate:

8' South Cen L Rd., and 23' East of Fence South. J. Hunt Fd 3/4" pipe
Recorded Liber 1, Page 150.