

NOV 15 1994

LAND CORNER RECORDATION CERTIFICATE
Filing Requirement of Act 74, Mich. P.A. 1970

OCT 18 12 02 PM '94

LIBER 4 PAGE 155
For corners in Almena Township

Van Buren County
(County)

Located In:

Corner Code #

Mark A. Smith
VAN BUREN CO
REGISTER OF DEEDS

7.00

- 1. Public Land Survey T 2S R13W I-4
W $\frac{1}{4}$ Post Sec 11 T _____ R _____
T _____ R _____
T _____ R _____
- 2. Property Controlling S _____ T _____ R _____
in Section S _____ T _____ R _____
- 3. Miscellaneous S _____ T _____ R _____
Property in Sec. S _____ T _____ R _____

Register of Deeds Stamp & File Number

- 4. Lot No. _____, Recorded Plat _____
- 5. Private Claims _____

	A	B	C	D	E	F	G	H	I	J	K	L	M
2	6	5	4	3	2	1							
3													
4	7	8	9	10	11	12							
5													
6	18	17	16	15	14	13							
7													
8	19	20	21	22	23	24							
9													
10	30	29	28	27	26	25							
11													
12	31	32	33	34	35	36							
13													

I, Donald R. Gilchrist, in a field survey on June 29, 1994

do hereby certify that under requirements of P.A. 74, Michigan P.A. of 1970, the corner points mentioned in lines 1 and 2 above were in conformance with regulations and rules therefore as required in the current manual of survey instructions of the United States Department of the Interior, Bureau of Land Management or by a decree of a Court of Law and/or that the corner points mentioned in lines 3, 4 and 5 above were in conformance with the rules of the Michigan Board of Land Surveyors or by a Decree of a Court of Law; established, re-established, monumented, re-monumented, recovered, found as expressed below:

NOTE: Not more than 4 corners, all in the same town and range, may be recorded on this certificate.

A. Description of original monument and accessories and/or subsequent restoration:

Government - set $\frac{1}{4}$ Post; 8" TAM - S 20° W 300 lks; 4" TAM S 16° E 140 lks. A.J. Teed (1874) found nothing. W.H. Goss (1899-1905) found stake previously set. 1 Gov't Wit is alive now, the other is down. This cor is 1.90 chains W of a straight line betwen sec cor. W.Q. Smith (1960) set pipe 2657.82' South of pipe near NW cor.

B. Description of corner evidence found and/or method applied in restoring or reestablishing corner:


Found stone down 4.5 with pieces of wood stake under. Set Harrison Marker over. Corner approved at Peer Group Meeting on 5/20/92, recorded in Liber 3, page 239. Corner was field checked on 6/22/94 by D.R. Gilchrist, Co.Surveyor. Approved at the 6/29/94 Van Buren County Peer Group Meeting and is accepted as a careful and faithful perpetuation of the position of the Original Government Corner.

Ratified by Peer Group in accordance with P.A. 345 of 1990
Van Buren County Surveyor

Date D. R. G. 10/18/94

C. Description of monument for corner and accessories established to perpetuate locating the position of the corner:

Harrison Marker
4" Elm - N 45° E 21.44
4: Elm - East 10.09
Wrver Sign - S 10° W 57.75
CL Rd 21.00' West of corner
Set a sur marker post East of corner 2'

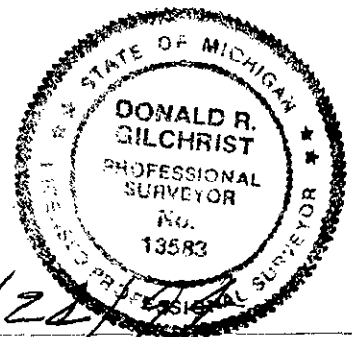

Signed by Donald R. Gilchrist Date 9/22/94

Surveyor's Michigan License No. Donald R. Gilchrist, RLS #13583