

SURVEY & MONUMENTATION

FILED

NOV 15 1994

Oct 18 12 02 PM '94

LIBER 4 PAGE 157

LAND CORNER RECORDATION CERTIFICATE
Filing Requirement of Act 74, Mich. P.A. 1970

For corners in Almena Township
Van Buren County
(County) Located In: Corner Code #

Mark A. Smith
VAN BUREN CO
REGISTERED PROFESSIONAL SURVEYOR

7.00
10/18 0101 10SURVEY

- 1. Public Land Survey T 2S R 13W I-5
SW Cor. Sec. 11 T R
T R
T R
- 2. Property Controlling S T R
in Section S T R
- 3. Miscellaneous S T R
Property in Sec. S T R
- 4. Lot No. _____, Recorded Plat _____
- 5. Private Claims _____

Register of Deeds Stamp & File Number

I, Donald R. Gilchrist, a field survey on June 29, 1994, do hereby certify that under requirements of P.A. 74, Michigan P.A. of 1970, the corner points mentioned in lines 1 and 2 above were in conformance with regulations and rules therefore as required in the current manual of survey instructions of the United States Department of the Interior, Bureau of Land Management or by a decree of a Court of Law and/or that the corner points mentioned in lines 3, 4 and 5 above were in conformance with the rules of the Michigan Board of Land Surveyors or by a Decree of a Court of Law; established, re-established, monumented, re-monumented, recovered, found as expressed below:

	A	B	C	D	E	F	G	H	I	J	K	L	M
2	6	5	4	3	2							7361	
3													
4	7	8	9	10	11	12							
5													
6	18	17	16	15	14	13							
7													
8	19	20	21	22	23	24							
9													
10	30	29	28	27	26	25							
11													
12	31	32	33	34	35	36							
13													

NOTE: Not more than 4 corners, all in the same town and range, may be recorded on this certificate.

A. Description of original monument and accessories and/or subsequent restoration:

Gov't - Set Post, 20" Maple S 82 1/2° E 14 lk., 6" Beech S 42° W 24 lk.
A.J. Teed, 1873, Fd. log of Gov. Witness Tree & remains of other wit tree.
A.A. Fosdick, 1885, Fd. as above. Geo. Mutchler, 1898, Fd. iron & stake said to have been set. W.H. Goss 1899-1905, Fd. iron bar in Rd. no Wit.
T.A. Smith, about 1945, Fd. iron bar. W.Q. Smith, 1965, Reset washing machine crank from old notes. MDOT - Lczubak, about 1967, Fd. 3/4" iron rod C/L of Road. D. Ratekin fd. 3/4" iron rec. L1, P520.

B. Description of corner evidence found and/or method applied in restoring or reestablishing corner:


Fd. washing machine crank as re-established by S&S from old note in 1965 (Bent).
Set Harrison Marker.
Approved by Peer Group on 5/20/92, recorded in Liber 3, P 242-243.
Corner was field checked by D.R. Gilchrist, County Surveyor, on 6/22/94
Approved at the 6/29/94 Van Buren County Peer Group Meeting and is accepted as a careful and faithful re-establishment of the position of the Original Government Corner.

Ratified by Peer Group in accordance with P.A. 345 of 1990
Van Buren County Surveyor

Date D. R. G. 10/18/94

C. Description of monument for corner and accessories established to perpetuate locating the position of the corner:

Harrison Marker
P.P. - S 49°04' W 212.93 to nail N. side
P.P. - N 35°50' W 280.91 to nail N. side
"X" in S end 12" Conc Culv N 82°50' E 27.84
"X" in N end 12" Conc Culv N 45°57' E 38.80
3' W C/L/ Rd.

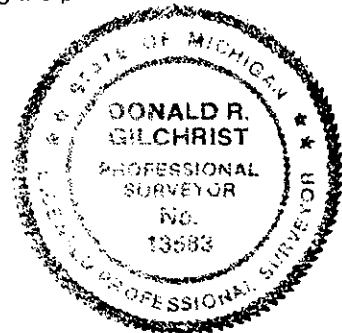

Signed by Donald R. Gilchrist Date 9/22/94
Surveyor's Michigan License No. Donald R. Gilchrist, RLS #13583