

JUN 29 1995

FEB 17 2 31 PM '95

COMMISSION

LAND CORNER RECORDATION CERTIFICATE

For corners in Almena Township Filing Requirement of Act 74, Mich. P.A. 1970
Van Buren County

Mark A. Smith
VAN BUREN CO.
REGISTER OF DEEDS

7-00

Located in: _____ Corner Code # _____

1. Public Land Survey T 2S R 13W Corner Code # J -5
 Section 14 N 1/4 P T _____ R _____
 T _____ R _____
 T _____ R _____

2. Property Controlling S _____ T _____ R _____
 in Section S _____ T _____ R _____

3. Miscellaneous S _____ T _____ R _____
 Property in Sec. S _____ T _____ R _____

4. Lot No. _____, Recorded Plat _____

5. Private Claims _____

LIBER 4 PAGE 282

Register of Deeds Stamp & File Number

02/17 0101 105URVEY

Donald R. Gilchrist February 3, 1995
 I, _____ in a field survey on _____ 19____
 do hereby certify that under requirements of P.A. 74, Michigan P.A. of 1970, the corner points mentioned in lines 1 and 2 above were in conformance with regulations and rules therefore as required in the current manual of survey instructions of the United States Department of the Interior, Bureau of Land Management or by a decree of a Court of Law and/or that the corner points mentioned in lines 3, 4 and 5 above were in conformance with the rules of the Michigan Board of Land Surveyors or by a Decree of a Court of Law; established, re-established, monumented, re-monumented, recovered, found as expressed below:

A	B	C	D	E	F	G	H	I	J	K	L
2	6	5	4	3	2	1					
3											
4	7	8	9	10	11	12					
5											
6	18	17	16	15	14	13					
7											
8	19	20	21	22	23	24					
9											
10	30	29	28	27	26	25					
11											
12	31	32	33	34	35	36					
13											

NOTE: Not more than 4 corners, all in the same town and range, may be recorded on this certificate.

A. Description of original monument and accessories and/or subsequent restoration:

See reverse

B. Description of corner evidence found and/or method applied in restoring or reestablishing corner:

Approved at the Van Buren County Peer Group Meeting on January 25, 1995 to set monument at the location of the iron, re-established by G. Mitchell. Found iron and checked wits., set Harrison Marker.

Approved at the January 25, 1995, Van Buren County Peer Group Meeting and is accepted as a careful and faithful perpetuation of the position of the Original Government Corner.


Validated by Peer Group in accordance with P.A. 345 of 1998
Van Buren County Surveyor

Date 1/25/95 *[Signature]*

C. Description of monument for corner and accessories established to perpetuate locating the position of the corner:

Harrison Marker

- 20" Ash - S - 6.74' Pk/w in west side.
- 8" Ash - S80°W - 30.80' to Pk/w in north side
- 10" Sass - N50°W - 34.77' to Pk/w in northeast side
- 12" Oak - N30°E - 21.63' to Pk/w in northwest side
- Centerline Road W. 14.7
- 1' south of south side of house to west.

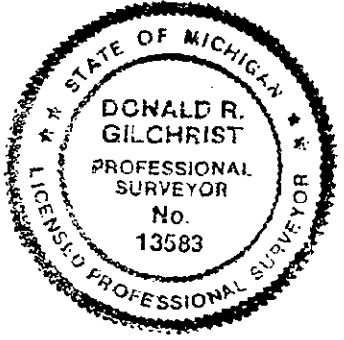

Signed by *Donald R. Gilchrist*

Date 2/15/95

Surveyor's Michigan License No. Donald R. Gilchrist, RLS #13583

4/1830 - G. W. Harrison, D.S.
Corrected Quarter Post to 39.70 chs. (2620.2').

LIBER 4 PAGE 283

Witnesses:

14" Beech - S. 18 Deg. E. - 12 lks. (7.92').
10" Butternut - N. 65 Deg. W. - 17 lks. (11.22').

12/27/1873 - A. J. Teed, C.S.

Book 4 - Page 147 (Section 14).

See information with South Quarter Post.

"Ran Quarter Lines, set Center Quarter Post. Found both witness trees and set Stake".
North Quarter Post South to Eighth Post = 20.09 chs. (1325.94') and continued South
to Center Quarter Post 20.09 chs. (1325.94') for a total of 2651.88'.

11/26/1885 - A. A. Fosdick, C.S.

Book 5 - Page 19 (Section 14).

"Found old Stake, ran Quarter Lines, set Center Quarter Post".
Distance South to Center Quarter Post = 40.34 chs. (2662.44').

2/17/1905 - W. H. Goss, C.S.

Section 11.

"Found Stake said by Gilbert Wright to be correct".

Witnesses:

10" Hickory - N. 86 Deg. E. - 94 lks. (62.04').
18" White Oak - S. 11 Deg. E. - 139.75 lks. (92.23').
Measured West to Eighth Post 19.98 chs. (1318.68') and continued West 19.98 chs.
(1318.68') to Southwest Corner for a total of 2637.36'.
Measured East to Southeast Corner 39.59 chs. (2612.94').
Measured North to Eighth Post 20.12 chs. (1327.92') and continued North to Center
Quarter Post 20.12 chs. (1327.92') for a total of 2655.84'.

2/1967 - M.D.O.T. (L. Czubak).

Found 1.25" Pipe.

Measured East 2612.29' to Northeast Corner.

Measured West 2629.90' to Northwest Corner.

Measured South 2661.66' to Center Quarter Post.

Witnesses:

14.5' East of Center Line of Road.
12" Twin Oak - S. 15 Deg. E. - 52.46'.
13" Maple - N. 80 Deg. E. - 42.64'.
SE. corner of foundation ISFH #3993 - West - 96.32'.

7/1972 - D. A. Ratekin, R.L.S.

Must of had a Quarter Section breakdown.

Survey Recorded (Liber 2 - Page 185).

Witnesses:

Center Line of Road - W. - 14.75'.
Nail in 24" Poplar - N. 5 Deg. E. - 11.56'.
Nail in 15" Maple - N. 80 Deg. E. - 43.60'.
Nail in 10" Oak - S. 60 Deg. E. - 17.49'.
1' South of South side of House to West.

Recordation Certificate (Liber 1 - Page 520). Witnesses same as above.

4/1976 - W. Q. Smith, R.L.S. (Gove).

Recorded Survey (Liber 6 - Page 101). Shows Northwest Quarter breakdown.

Measured West to Eighth Post 1314.95' and continued West 1314.95' to Northwest
Corner for a total of 2629.90'.

Measured South to Eighth Post 1330.83' and continued South 1330.83' to Center Quarter
Post for a total of 2661.66' (no witnesses).

No Date - Ingersoll, Watson & McMachen.

Survey notes say "North 1/4 Post has been dug out by D.N.R. to place C.M.P" as per
old man at house NW. of corner.

10/28/1993 - G. Mitchell, P.S.

Survey in Northwest Quarter of Section 14.

Reset 1/2" Iron With Cap.

Distance South to Eighth Post = 1330.76'.

Survey Notes: "Used existing center and 1/8 post on 1/4 line north of center and doubled
for N 1/4 post. Angles and distances agree with Gove Survey, recorded in Liber 6 - Page
101, 1976".

Witnesses:

Nail & Cap N. side 20" Poplar - S. - 5.95'. *5.74*
Nail & Cap N. side 8" Ash - S. 80 Deg. W. - ~~30.54~~ *30.80*
Nail/Washer NE. side 10" Sassafras - N. 50 Deg. W. - 34.77'.
Nail/Washer NW. side 12" Oak - N. 30 Deg. E. - 21.63'.
Center Line Road - W. - 14.7'.