

MAY 16 1997

DEC 10 8 23 AM '96

COMMISSION

LAND CORNER RECORDATION CERTIFICATE  
Filing Requirement of Act 74, Mich. P.A. 1970

*Mark A. Smith*  
VAN BUREN CO.  
REGISTERED PROFESSIONAL SURVEYOR

9.00

For corners in Waverly Township

Van Buren County (County)	Located In:	Corner Code #
1. Public Land Survey	T2S R 14W	A-5
SW Corner Sec 7	T R	
	T R	
	T R	
	T R	
2. Property Controlling in Section	S T R	
	S T R	
3. Miscellaneous Property in Sec.	S T R	
	S T R	

Register of Deeds Stamp & File Number

3744 12/09 0101 105URVEY

4. Lot No. \_\_\_\_\_, Recorded Plat \_\_\_\_\_  
 5. Private Claims \_\_\_\_\_

I, Donald R. Gilchrist, in a field survey on November 6, 1996 do hereby state that under requirements of P.A. 74, Michigan P.A. of 1970, the corner points mentioned in lines 1 and 2 above were in conformance with regulations and rules therefore as required in the current manual of survey instructions of the United States Department of the Interior, Bureau of Land Management or by a decree of a Court of Law and/or that the corner points mentioned in lines 3, 4 and 5 above were in conformance with the rules of the Michigan Board of Land Surveyors or by a Decree of a Court of Law; established, re-established, monumented, recovered, found as expressed below:


NOTE: Not more than 2 corners, all in the same town and range, may be recorded on this certificate.

	A	B	C	D	E	F	G	H	I	J	K	L
1												
2	6			5			4			3		2
3												
4	7			8			9			10		11
5												
6	18			17			16			15		14
7												
8	19			20			21			22		23
9												
10	30			29			28			27		26
11												
12	31			32			33			34		35
13												

A. Description of original monument and accessories and/or subsequent restoration:  
**4/1830 - GOVERNMENT - G. W. Harrison, D.S.**  
 West between Sections 7 and 18 a distance of 74.30 chs (4903.80') and intersected West boundary 87 lks (57.42') North of Post. Set Post (no witnesses).  
**6/24/1922 - W. H. Goss, C.S.**  
 Red Book. Stake in Sewer Pipe (could be a Tile).  
 (Continued on back of Certificate)

B. Description of corner evidence found and/or method applied in restoring or reestablishing corner:  
 Reset Harrison Marker on line to NE corner of Section 12, Arlington in Mon Box at 57.50'.  
 Approved at the 10/25/95 meeting of the Van Buren County Peer Group.  
 Measured distance East = 4903.94'.  
 And is accepted as a careful and faithful re-establishment of the position of the original corner.

C. Description of monument for corner and accessories established to perpetuate locating the position of the corner:  
 Harrison Marker in Mon Box.  
 15" Elm - N 30 Deg E - 58.27'.  
 5" Will - N 30 Deg W - 54.61'.  
 M-43 sign - S 88 Deg W - 136.15'.  
 M-43 sign - S 60 Deg E - 119.39'.  
 3' E of CL 46th St.  
 32' - N of CL M-43.  
 Town Line jog = 57.50'.

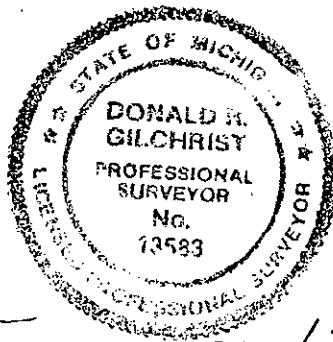

Ratified by Peer Group in accordance with P.A. 345 of 1990  
 Van Buren County Surveyor  
 Date 12/19/96 *D. R. G.*

Signed by *Donald R. Gilchrist*  
 Surveyor's Michigan License No. RLS 13583

Date 12/2/96

**Witnesses:**

West end of Tube - SW - 21.5 lks (14.19')

East end Tube - SE - 19.5 lks (12.87')

**6/1939 - M.D.O.T.**

Shows jog at 57.50'

Found Boat Spike in Tile and Witnesses.

Arlington Corner is a Stone.

**10/18/1995 - Don R. Gilchrist. C.S.**

Dug hole 3' +- East and West and 1.5' North and South to a depth of 3' and found nothing.

Set temporary Iron on line to Northeast Corner.

*LIBER 4 PAGE 372*