

LAND CORNER RECORDATION CERTIFICATE

FILING REQUIREMENT OF ACT 74, MICH. P.A. 1970

DEC 17 9 27 AM '98

W 1/4 POST SEC 8 T2S R14 W Waverly Twp

Mark A. Smith
VAN BUREN CO.
REGISTER OF DEEDS

FOR CORNERS OF--	LOCATED IN--	CORNER CODE NUMBER
1. PUBLIC LAND SURVEY	T. 2 S., R. 14 W. ^{MX} _{EX}	C-4
2. PROPERTY CONTROLLING IN SECTION	, T. _____ N. S., R. _____ E. W.	
3. MISCELLANEOUS PROPERTY IN SECTION	, T. _____ N. S., R. _____ E. W.	
4. LOT NO. _____	, RECORDED PLAT _____	
5. PRIVATE CLAIMS _____		

LIBER 5 PAGE 176

REGISTER OF DEEDS STAMP AND FILING NUMBER

3395 12/17 0101 LOSUR

I, CHARLES D. LOSSIE, do hereby certify that under requirements of P.A. 74, Michigan P.A. of 1970, the corner points mentioned in lines 1 and 2 above were, in a field survey on 12/10, 1998, established, re-established, monumented, re-monumented, recovered or restored as expressed below and in conformance with regulations and rules therefore as required in the current manual of survey instructions of the United States Department of the Interior, Bureau of Land Management or by a decree of a court of law. Furthermore, that the corner points mentioned in lines 3, 4 and 5 above were, in a field survey on _____, 19____, found, recovered, restored, established or re-established as expressed below and in conformance with the rules of the Michigan State Board of Registration for Land Surveyors or, by a Decree of a Court of law:

A. Description of original monument and accessories and/or subsequent restoration:

SEE BACK SHEET

SURVEY & REMONUMENTATION

JAN 11 1999

SECTION

Ratified by Peer Group in accordance with P.A. 345 of 1990
Van Buren County Surveyor

Date D. R. S. 12-17-98

B. Description of corner evidence found and/or method applied in restoring or re-establishing corner:


FOUND 1" IRON BAR SET BY M.S.H.D. IN 1962. THE FOUND 1" IRON BAR WAS ACCEPTED AS THE BEST AVAILABLE EVIDENCE OF THE POSITION OF THE ORIGINAL CORNER AT THE PEER GROUP MEETING HELD 12/9/98.

C. Description of monument for corner and accessories established to perpetuate locating the position of the corner:

TIED OFF 1" IRON BAR. SET HARRISON MARKER.
POWER POLE WEST 51.89' TO PK AND WASHER.
36" MAPLE N.30°W. 68.85' (THE TREE WAS USED AS WITNESS BY M.S.H.D.)
SEE HISTORY
8" CHERRY N.45° E. 68.85' TO PK AND WASHER.
8" CHERRY S.30° W. 109.75' TO PK AND WASHER.

SIGNED BY Charles D. Lossie DATE 12/17/98

SURVEYOR'S MICHIGAN REGISTRATION NO. 44291

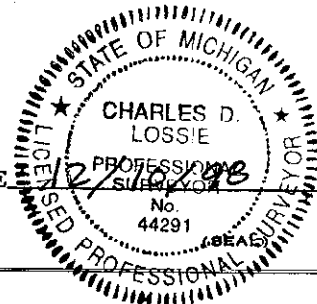

FOR STATE AND UNITED STATES AGENCIES:

SIGNED BY _____ DATE _____

CHIEF OF SURVEY PARTY

APPROVED AND SIGNED BY _____ DATE _____

MICHIGAN REGISTERED LAND SURVEYOR

(SEAL)

SURVEYOR'S MICHIGAN REGISTRATION NO. _____

LIBER 5 PAGE 177

4/8/1830 - GOVERNMENT - G. W. HARRISON, D.S.

Ran North between Sections 7 & 8 a distance of 40.00 chs. (2640.00') and set post corner.

WITNESSES: 9" Beech N. 78° E. - 13 lks. (8.58').
18" Maple - N. 61° W. - 10 lks. (6.60').

1/24/1868 - C.D. LAWTON, C.S.

Book 2 - Page 70 and Red Book. Found one witness tree and stake.

Distance South is 40 chs. (2640.00').

Distance North is 19.885 chs. (1312.41') and continuing 1312.41' to Section Corner for a total of 2624.82'.

Distance East is 19.985 chs. (1319.01') and continuing 1319.01' to Center Quarter Post for a total of 2638.02'.

3/18/1962 -M.S.H.D.

Set by doubling from fence intersection at center of section and North and South Eighth line fence. 2640' East of center of section.

WITNESSES: 34" Maple - N. 35° W. - 55.91'.
T. Pole - N. 38° E. - 73.24'
12" Cherry - West - 77.92'
Fence Corner - West 25.8'.
Fence Corner - West - 33.00'.

11/12/1971 - W.Q. SMITH, C.S. & D.A. MIDDLETON, R.L.S.

Section 8. Notes and worksheet - Recorded Survey (Liber 1 - Page 197).

Distance North is 2634.19'.

Distance South is 2652.03'.

Distance East is 2648.02'.

**SURVEY &
REMONUMENTATION**

JAN 11 1999

SECTION