

**SURVEY &  
REMONUMENTATION**

FILED

APR 25 1995

**LAND CORNER RECORDATION CERTIFICATE**

DEC 13 9 44 AM '94

**COMMISSION**

Filing Requirement of Act 74, Mich. P.A. 1970

For corners in Waverly Township

*Mark R. Smith*  
REGISTERED SURVEYOR

9-00

Van Buren County Located in: \_\_\_\_\_ Corner Code # \_\_\_\_\_  
(County)

- 1. Public Land Survey T 2S R 14W C-5 \_\_\_\_\_  
SW Corner Section 8 T \_\_\_\_\_ R \_\_\_\_\_  
T \_\_\_\_\_ R \_\_\_\_\_  
T \_\_\_\_\_ R \_\_\_\_\_
- 2. Property Controlling S \_\_\_\_\_ T \_\_\_\_\_ R \_\_\_\_\_  
in Section S \_\_\_\_\_ T \_\_\_\_\_ R \_\_\_\_\_
- 3. Miscellaneous S \_\_\_\_\_ T \_\_\_\_\_ R \_\_\_\_\_  
Property in Sec. S \_\_\_\_\_ T \_\_\_\_\_ R \_\_\_\_\_

*LIBER 4 PAGE 225*

Register of Deeds Stamp & File Number

9085 12/13 0101 10SURVEY

- 4. Lot No. \_\_\_\_\_, Recorded Plat \_\_\_\_\_
- 5. Private Claims \_\_\_\_\_

A	B	C	D	E	F	G	H	I	J	K	L	M
2	6	5	4	3	2	1						
3												
4	7	8	9	10	11	12						
5												
6	18	17	16	15	14	13						
7												
8	19	20	21	22	23	24						
9												
10	30	29	28	27	26	25						
11												
12	31	32	33	34	35	36						
13												

I, Donald R. Gilchrist December 9 1994  
do hereby certify that under requirements of P.A. 74, Michigan P.A. of 1970, the corner points mentioned in lines 1 and 2 above were in conformance with regulations and rules therefore as required in the current manual of survey instructions of the United States Department of the Interior, Bureau of Land Management or by a decree of a Court of Law and/or that the corner points mentioned in lines 3, 4 and 5 above were in conformance with the rules of the Michigan Board of Land Surveyors or by a Decree of a Court of Law; established, re-established, monumented, re-monumented, recovered, found as expressed below:

**NOTE: Not more than 4 corners, all in the same town and range, may be recorded on this certificate.**

A. Description of original monument and accessories and/or subsequent restoration:

5/1827 - GOVERNMENT - William Brookfield, D.S.  
North between Sections 17 and 18 a distance of 80.00 chs. (5280.00') and set Post Corner for Sections 7, 8, 17 & 18

WITNESS:

- 5" Beech - S. 11 Deg. E. - 8 lks. (5.28')
- 15" Beech - N. 22 Deg. W. - 30 lks. (19.80')

Continued on Reverse

B. Description of corner evidence found and/or method applied in restoring or reestablishing corner:

Found Bolt Spike in Mon. Box  
W.Q. Smith 1971 Found


Approved at the November 30, 1994 Van Buren County Peer Group Meeting and is accepted as a careful and faithful re-establishment of the position of the Original Government Corner.

Notified by Peer Group in accordance with P.A. 345 of 1990  
Van Buren County Surveyor

Date D. R. G. 12/13/94

C. Description of monument for corner and accessories established to perpetuate locating the position of the corner:

Harrison Slimline Marker in Mon. Box  
Power Pole N45°W 86.15' to pk & washer  
Light Pole N15°W 70.60' to pk & washer  
Power Pole S20°E 186.99' to pk & washer  
Centerline top of phone riser S30°W 82.76 feet

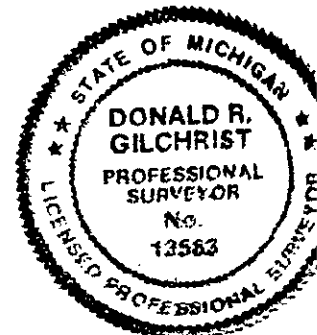

Signed by Donald R. Gilchrist Date 12/12/94

Surveyor's Michigan License No. Donald R. Gilchrist, RLS #13583

1/24/1868 - C. D. Lawton, C.S.

LIBER 4 PAGE 226

Book 2 - Page 70

"Found old stake and stump of one witness tree."

Distance North of 40.00 chs. (2640.00').

Distance East of 19.905 chs. (1313.73') to Eighth Post Stake, continued East 19.905 chs. (1313.73') to Quarter Post.

No Date - W. H. Goss, C.S.

Stone

Witnesses:

16" Maple - SW. - 37'.

20" Maple - NE. - 50'.

1949 - M.D.O.T. - R/W Map

Shows Corner 13.5' South of center line of M-43 Highway.

11/1971 - W. Q. Smith, C.S.

Survey Notes

Found Iron in Monument Box 18' (plus or minus) South of south edge of slab in asphalt apron.

Witnesses:

Center Line of Catch Basin - SW. - 52.15'.

Phone Pedestal - SW. - 83.40'.

Stop Sign - SE. - 51.53' to center line.